

## WATER SERVICE RECORD

Name DeVries Const. Co., Inc.

Service No. 206

Address 3 Wheeler Road

# 7224

Location

~~New Service~~ - New Service

Com 11-29-54

Date	Material	Amount	Total	Date	Amount
9/28/54	Labor	1 85		8-24-54	30 00
	10% overhead	19	2 04	11-29-54	6 76
	47' - 3/4" copper tubing@ .35		16 45		<u>23 24</u>
	1 - 3/4"C x 1/2 I.W.H. stop & waste		4 00	9/28/54	Labor
	1 hr. trucking		75		1 12
			23 24		19' - 3/4 copper tubing@ .35
	TRENCH DUG BY OWNER:				6 65
					1 - 3/4"C. corp-cock
					4 33
					1 - 3/4"C. curb-cock
					4 67
					1 box and rod
					3 90
					1 - 1/2 straight tail pc.
					50
					1 - 1/2 offset tail pc.
					50
					1 hr. trucking
					<u>75</u>
					22 42


\* Refund made payable to town  
 to apply on w. h. #210, #221  
 #211

DATE \_\_\_\_\_

TOWN OF LEXINGTON — BOARD OF PUBLIC WORKS

**WATER DIVISION**

Sketch of Service Here

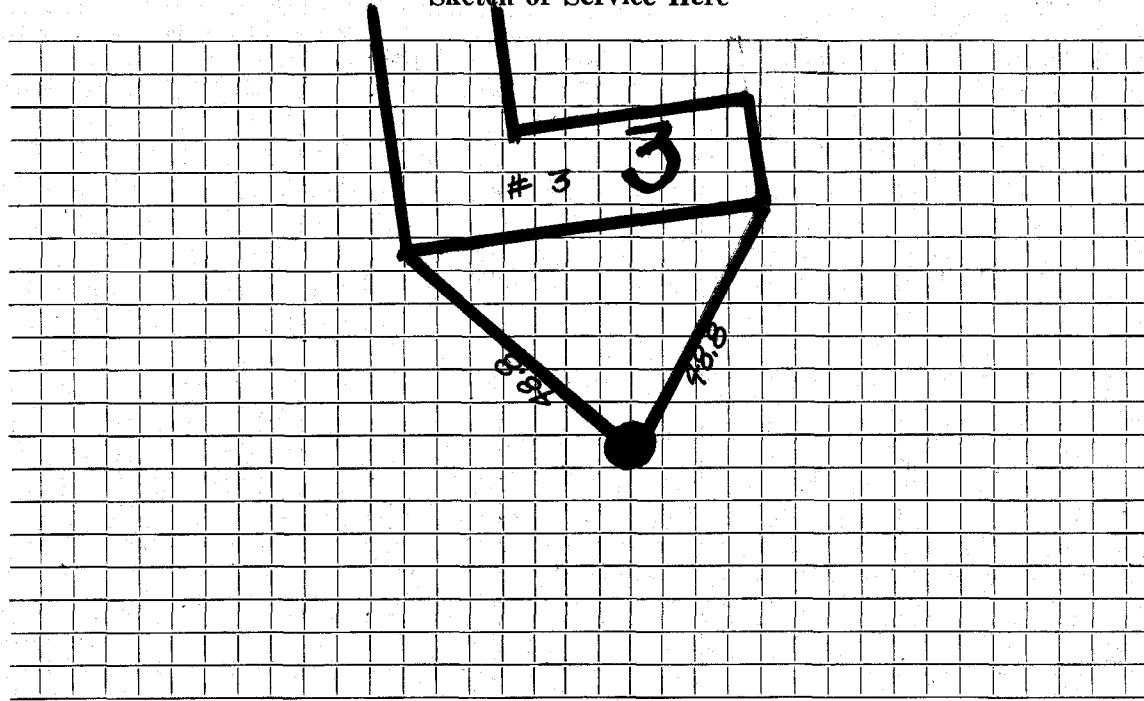

Connection made in ..... Street.      Work completed .....

Remarks: .....

.....

.....