

WATER SERVICE RECORD

Name DeVries Const. Co., Inc.

Service No. 207

Address 4 Wheeler Road

3204

7235

Location

~~Repair~~ - New Service

Com 11-29-54

Date	Material	Amount	Total	Date	Amount
9/28/54	Labor	1 85		8-24-54 Deposited	30 00
	10% overhead	19	2 04	11-29-54 * Refunded	15 71
	50' - 3/4" copper tubing@	.35	17 50	<u>NON CHARGE</u>	24 29
	1 - 3/4"C x 1/2 I.W.H. stop & waste		4 00	9/28/54 Labor	1 12
	1 hr. trucking		75	13' - 3/4" copper tubing@	4 55
			24 29	1 - 3/4"C. corp-cock	4 33
	TRENCH DUG BY OWNER:			1 - 3/4"C. curb-cock	4 67
				1 box and rod	3 90
				1 - 1/2 straight tail piece	50
				1 - 1/2 offset tail piece	50
				1 hr. trucking	75
					20 32


* \$2.63 of this refund made payable to town to apply on w.h.c. # 223

DATE _____

TOWN OF LEXINGTON — BOARD OF PUBLIC WORKS

WATER DIVISION

Sketch of Service Here

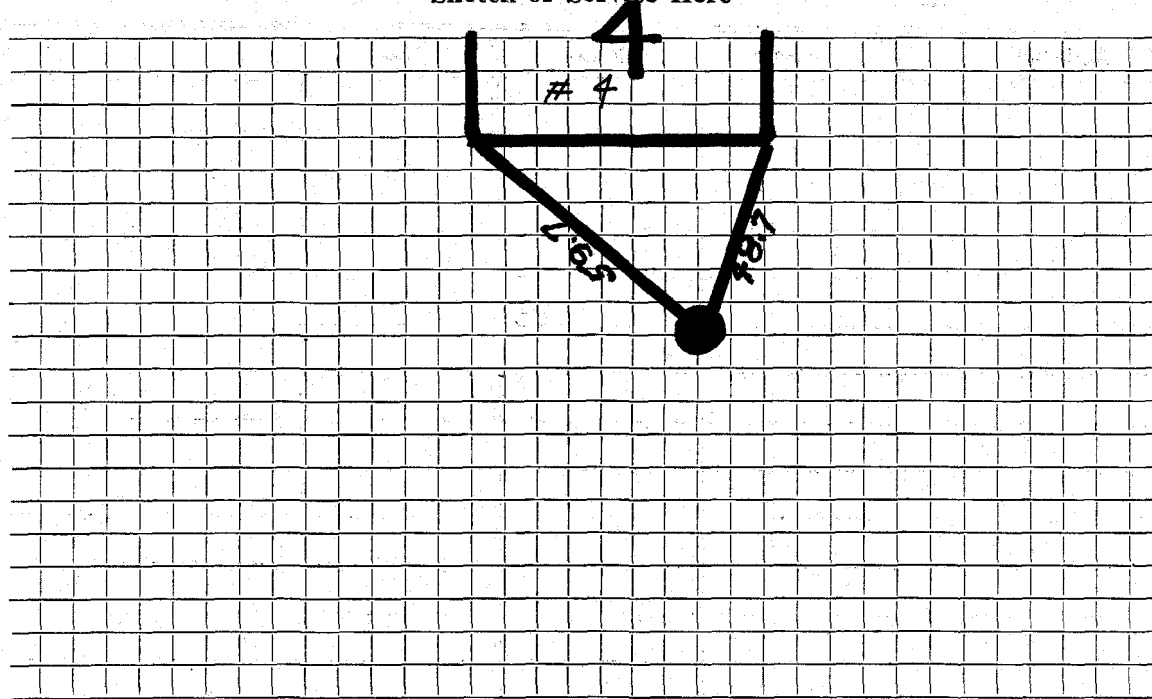

Connection made in Street. Work completed

Remarks:

.....

.....