

WATER SERVICE RECORD

Name DeVries Const. Co., Inc.

Service No. 208

Address 5 Wheeler Road

Location

~~REPAIR WORK~~ - New Service

*Com 11-29-54*


Date	Material	Amount	Total	Date	Amount
9/28/54	Labor	1 85		8-24-54	Deposited 30 00
	10% overhead	19	2 04	11-29-54	Refunded (5 71)
	50' - 3/4" Copper tubing@.35		17 50		<u>NON CHARGE</u> 24 29
	1 - 3/4" C x 1/2 I.W.H. stop & waste		4 00	9/28/54	Labor 1 12
	1 - hr. trucking		75		19' - 3/4" copper tubing@ .35 6 65
			24 29		1 - 3/4" C. c orb-cock 4 33
	TRENCH DUG BY OWNER:				1 - 3/4" C. curb-cock 4 67
					1 box and rod 3 90
					1 - 1/2 straight tail pc. 50
					1 - 1/2 offset tail pc. 50
					1 hr. trucking 75
					22 42

DATE \_\_\_\_\_

TOWN OF LEXINGTON — BOARD OF PUBLIC WORKS

**WATER DIVISION**

Sketch of Service Here

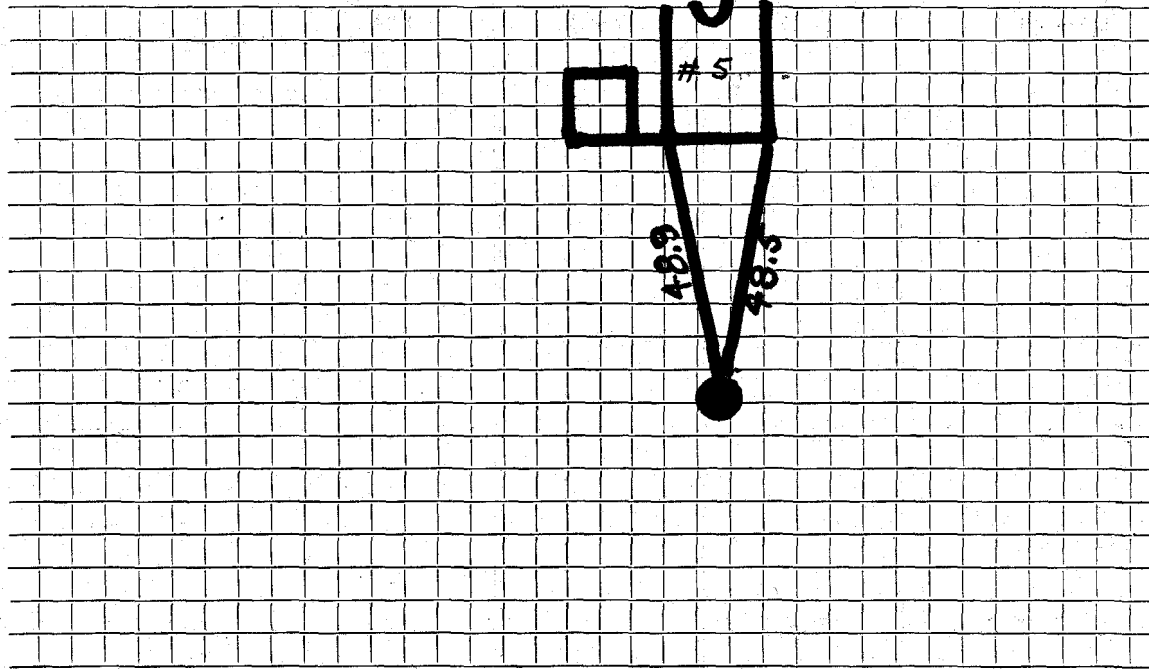

Connection made in ..... Street. Work completed .....

Remarks: .....

.....

.....