

WATER SERVICE RECORD

Name DeVries Const. Co., Inc.

Service No. 209

Address 6 Wheeler Road

Location

~~Road~~ - New Service

Com 11-29-54


Date	Material	Amount	Total	Date	Amount
9/28/54	Labor	1 85		8-24-54	Deposited 30 00
	10% overhead	19	2 04	11-29-54	Refunded (2 21)
	60' - 3/4" copper tubing @ .35		21 00		<u>NON CHARGE</u> 21 79
	1 - 3/4" C x 1/2 I.W.H. stop & waste		4 00	9/28/54	Labor 1 12
	1 - hr. trucking		75		13' - 3/4" copper tubing @ .35 4 55
			27 79		1 - 3/4" C. corp-cock 4 33
	TRENCH DUG BY OWNER:				1 - 3/4" C. curb-cock 4 67
					1 box and rod 3 90
					1 - 1/2 straight tail pc. 50
					1 - 1/2 offset tail pc. 50
					1 - hr. trucking 75
					<u>20 32</u>

DATE _____

TOWN OF LEXINGTON — BOARD OF PUBLIC WORKS

WATER DIVISION

Sketch of Service Here

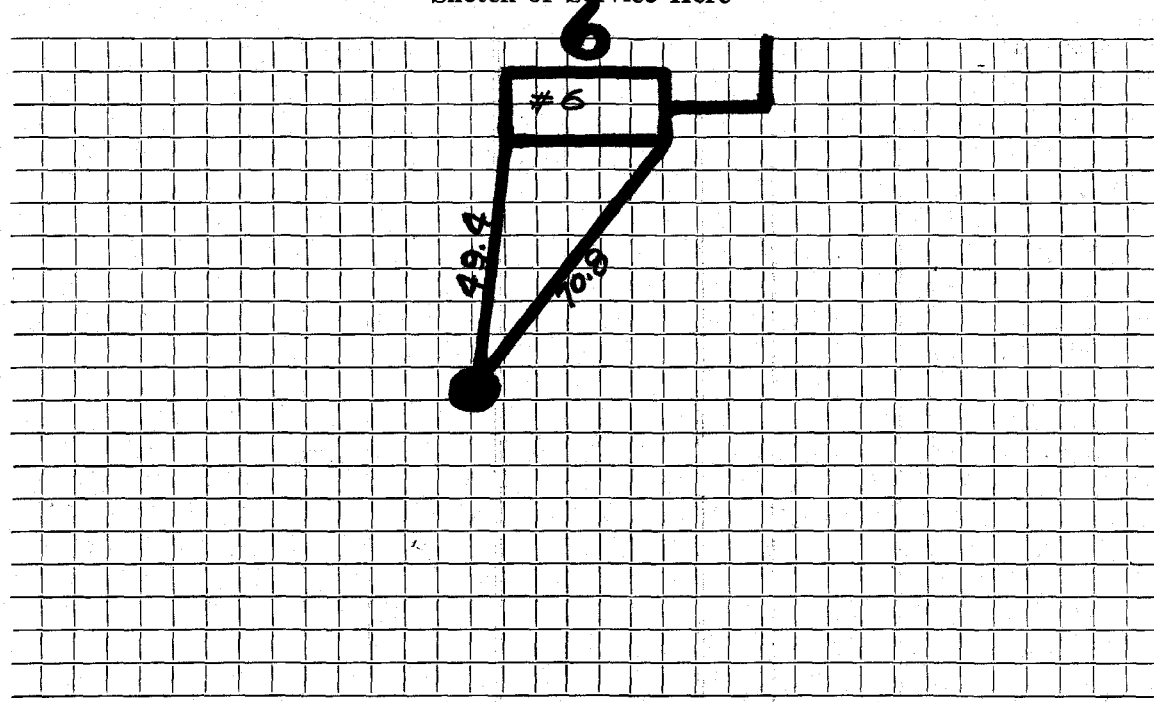

Connection made in Street. Work completed

Remarks:
.....
.....