

WATER SERVICE RECORD

Name DeVries Const. Co., Inc.

Service No. 210

Address 7 Wheeler Road

1791

Location

~~RENEWAL~~ New Service


Conn 11-29-54

Date	Material	Amount	Total	Date	Amount
9/28/54	Labor	1 85		8-24-54 Deposited	30 00
	10% overhead	19	2 04	11-29-54 Paid	92
	70' - 3/4" copper tubing@ .35		24 50		<u>2 69</u>
	1 - 3/4"C x 1/2 I.W.H. stop & waste	4 00			33 21
	1 - 3/4"C. union	1 72		9/28/54 Labor	1 12
	1 hr. trucking		75	19' - 3/4" copper tubing@ .35	6 65
			33 01	1 - 3/4"C. corp-cock	4 33
				1 - 3/4"C. curb-cock	4 67
	TRENCH DUG BY OWNER:			1 - box and rod	3 90
				1 - 1/2 straight tail pc.	50
				1 - 1/2 offset tail pc.	50
				1 hr. trucking	75
					<u>22 42</u>

DATE _____

TOWN OF LEXINGTON — BOARD OF PUBLIC WORKS
WATER DIVISION

Sketch of Service Here

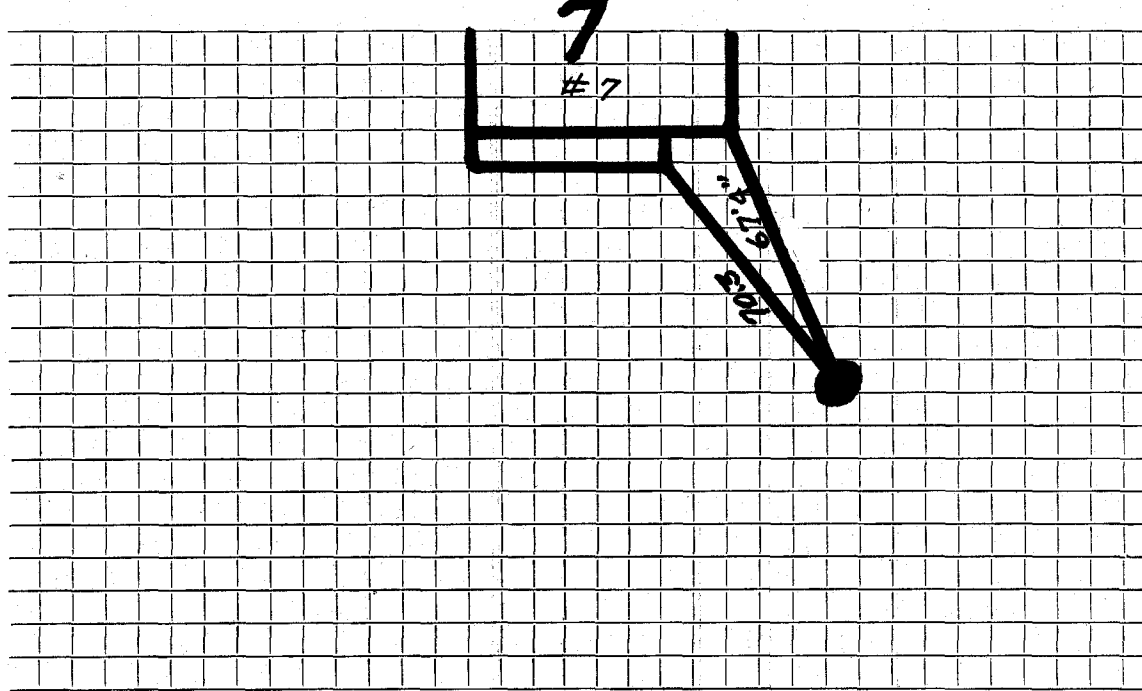

Connection made in Street. Work completed

Remarks:

.....

.....