

WATER SERVICE RECORD

3360

Name DeVries Const. Co., Inc.

Service No. 211

Address 8 Wheeler Road

Location

~~REPAIR WORK~~ - New Service

Com 11-29-54


Date	Material	Amount	Total	Date	Amount
9/28/54	Labor	1 85		<i>f-24-54</i>	<i>Deposited</i>
	10% overhead	19	2 04	<i>11-29-54</i>	<i>paid</i>
	66' - 3/4" copper tubing @ .35		23 10		<i>NON CHARGE</i>
	1 - 3/4"C x 1/2 I.W.H. stop & waste		4 00	9/28/54	Labor
	1 - 3/4"C. union		1 72		13' - 3/4" copper tubing @ .35
	1 hr. trucking		75		1 - 3/4"C. corp-cock
			31 61		1 - 3/4"C. curb-cock
	TRENCH DUG BY OWNER:				1 box and rod
					1 - 1/2 offset tail pc.
					1 - 1/2 straight tail pc.
					1 hr. trucking
					<u>20 32</u>

DATE _____

TOWN OF LEXINGTON — BOARD OF PUBLIC WORKS

WATER DIVISION

Sketch of Service Here

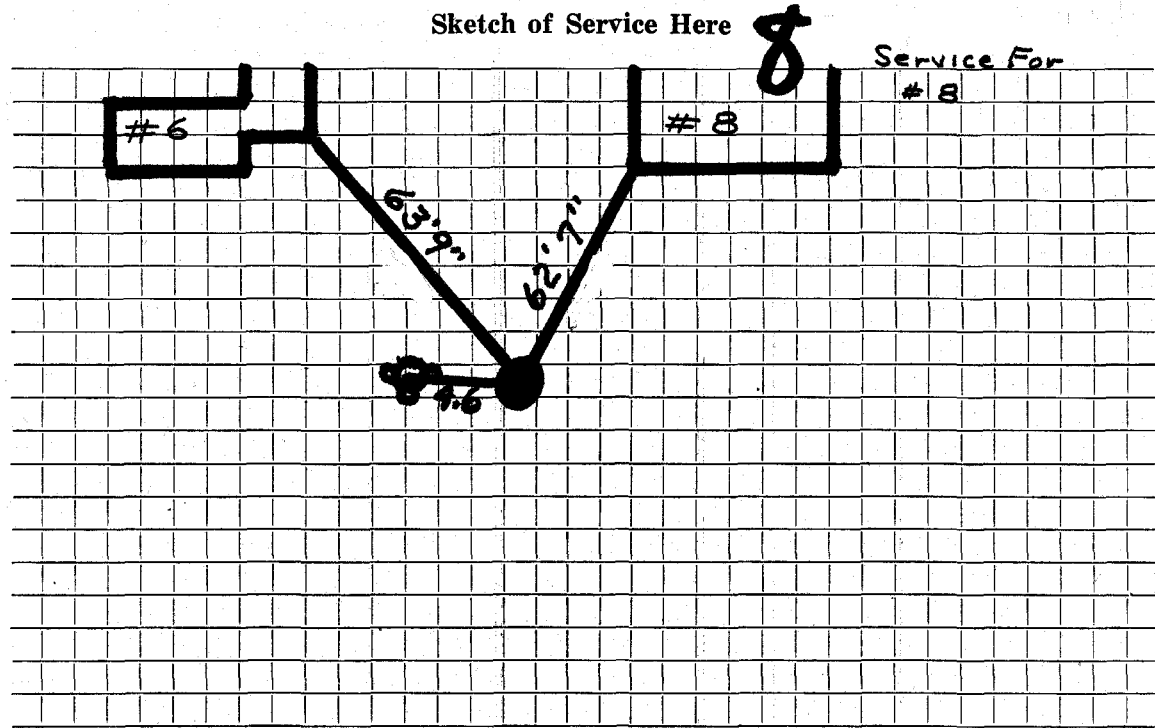

Connection made in Street. Work completed

Remarks:

.....

.....