

WATER SERVICE RECORD

Name DeVries Const. Co., Inc.

Service No. 212

Address 9 Wheeler Road

Location

~~REPAIR WORK~~ - New Service

Com 11-29-54


Date	Material	Amount	Total	Date	Amount
9/28/54	Labor	1 85		8-24-54	Deposited 20.00
	10% overhead	19	2 04	11-29-54	Paid 8.26
	85' - 3/4" copper tubing @.35		29 75		<u>NON CHARGE</u> 38.26
	1 - 3/4" C x 1/2 I.W.H. stop & waste		4 00	9/28/54	Labor 1 12
	1 - 3/4" C. union		1 72	19' - 3/4" copper tubing @.35	6 65
	1 hr. trucking		75	1 - 3/4" C. corp-cock	4 33
			38 26	1 - 3/4" C. curb-cock	4 67
	TRENCH DUG BY OWNER:			1 - box and rod	3 90
				1 - 1/2 straight tail piece	50
				1 - 1/2 offset tail piece	50
				1 hr. trucking	75
					<u>22 42</u>

DATE _____

TOWN OF LEXINGTON — BOARD OF PUBLIC WORKS

WATER DIVISION

Sketch of Service Here

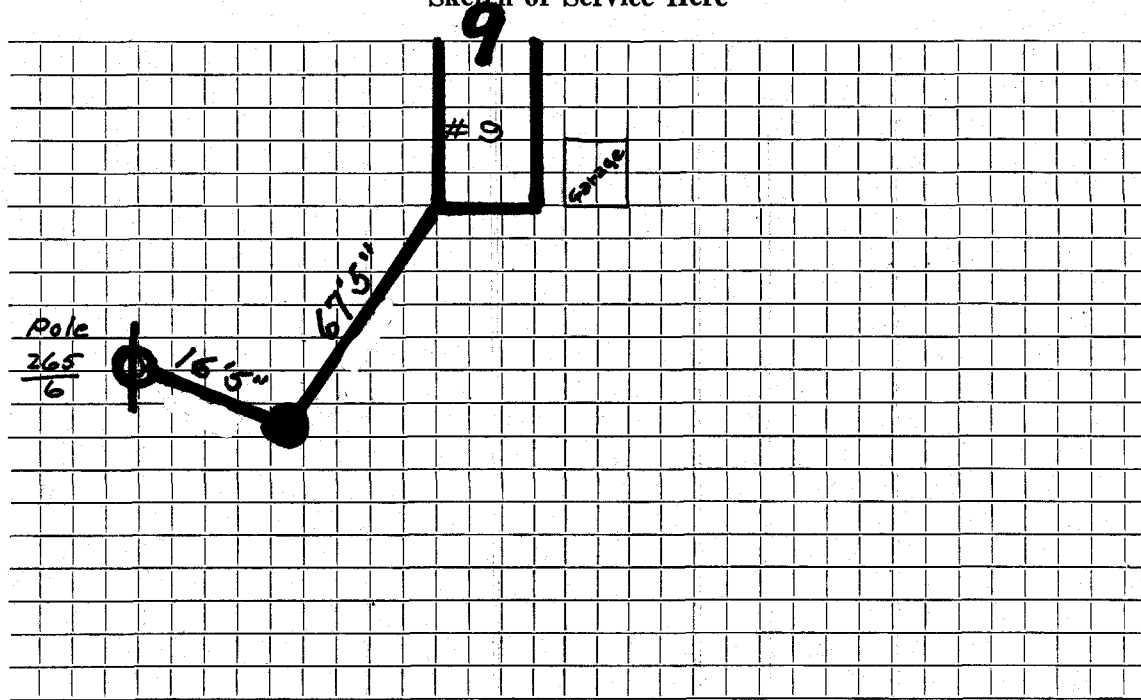

Connection made in Street. Work completed

Remarks:
.....
.....