

WATER SERVICE RECORD

Name DeVries Const. Co.

Service No. 45

Address 15 Whipple Road

Location

~~Repair~~ ~~Renewal~~ — New Service

Com. 3-21-55


Date	Material	Amount	Total	Date	Amount
2/28/55	Labor	1 85		3-2-55	Deposited 35 00
	10% overhead	19	2 04	3-21-55	Refunded (9 66
	53' - 3/4" copper tubing@.35		18 55		<u>NON CHARGE</u> 25 34
	1 - 3/4"C x 1/2 I.W.H. stop& waste		4 00	2/28/55	Labor 6 78
	1 - hr. trucking		75	15' - 3/4" copper tubing@.35	5 25
			25 34	1 - 3/4"C. corp-cock	4 33
	TRENCH DUG BY OWNER:			1 - 3/4"C curb-cock	4 67
				1 box and rod	3 90
				1 - 1/2 offset tail pc.	50
				1 - 1/2 straight tail pc.	50
				1 hr. trucking	75
					<u>26 68</u>

DATE _____

TOWN OF LEXINGTON — BOARD OF PUBLIC WORKS

WATER DIVISION

Sketch of Service Here

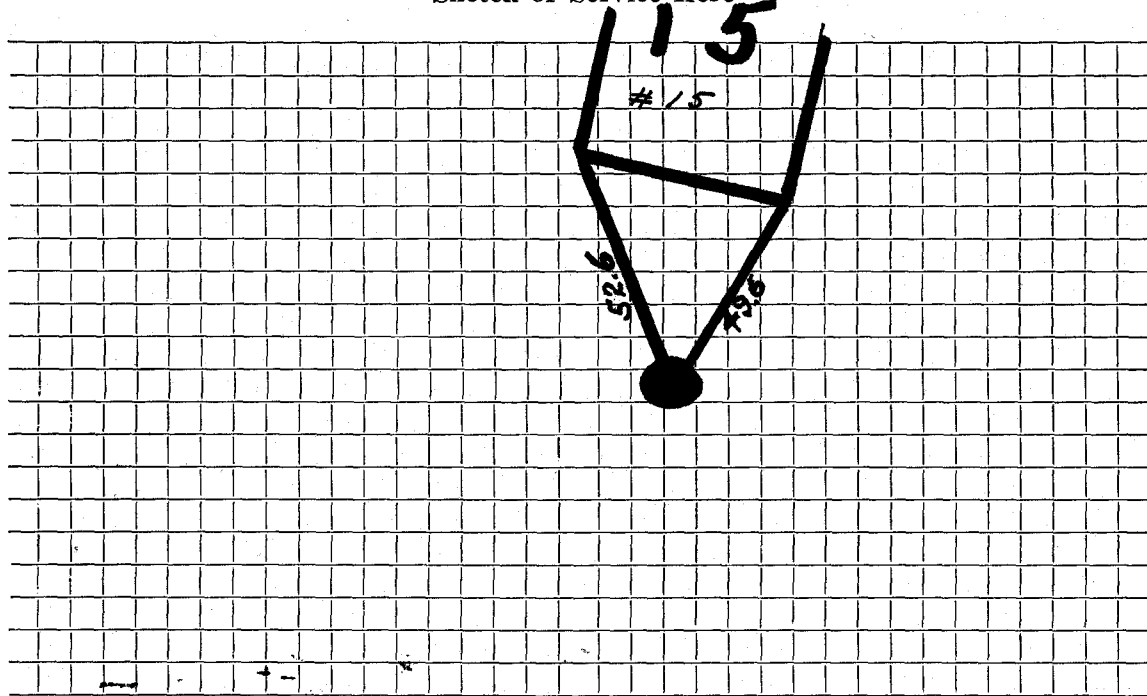

Connection made in Street. Work completed

Remarks:

.....

.....