

WATER SERVICE RECORD

Name Devries Const. Co.

Service No. 46

Address 17 Whipple Road

7442

Location

7465

~~Repair or Renewal~~ - New Service

Com 8-15-55


Date	Material	Amount	Total	Date	Amount
5/6/55	Labor	1 85		3-2-55	Deposited 35 00
	10% Overhead	19	2 04	8-15-55	Refunded 64
	70' - 3/4" Copper tubing @.3693	25 85			NON CHARGE 34 36
	1 - 3/4" C x 1/2 I.W.H. stop & waste	4 00	5/6/55	Labor	2 75
	1 - 3/4 C x 3/4 C. Union 3 pts.	1 72		10' - 3/4" Copper tubing @.3693	3 69
	1 hr. trucking		75	1 - 3/4" C. corp-cock	4 33
			<u>34 36</u>	1 - 3/4" C x 3/4 C. curb-cock	4 67
				1 box and rod	3 90
				1 - 1/2 offset tail piece	50
	TRENCH DUG BY OWNER			1 - 1/2 straight tail piece	50
				1 hr. trucking	75
					<u>21 09</u>

DATE _____

TOWN OF LEXINGTON — BOARD OF PUBLIC WORKS

WATER DIVISION

Sketch of Service Here

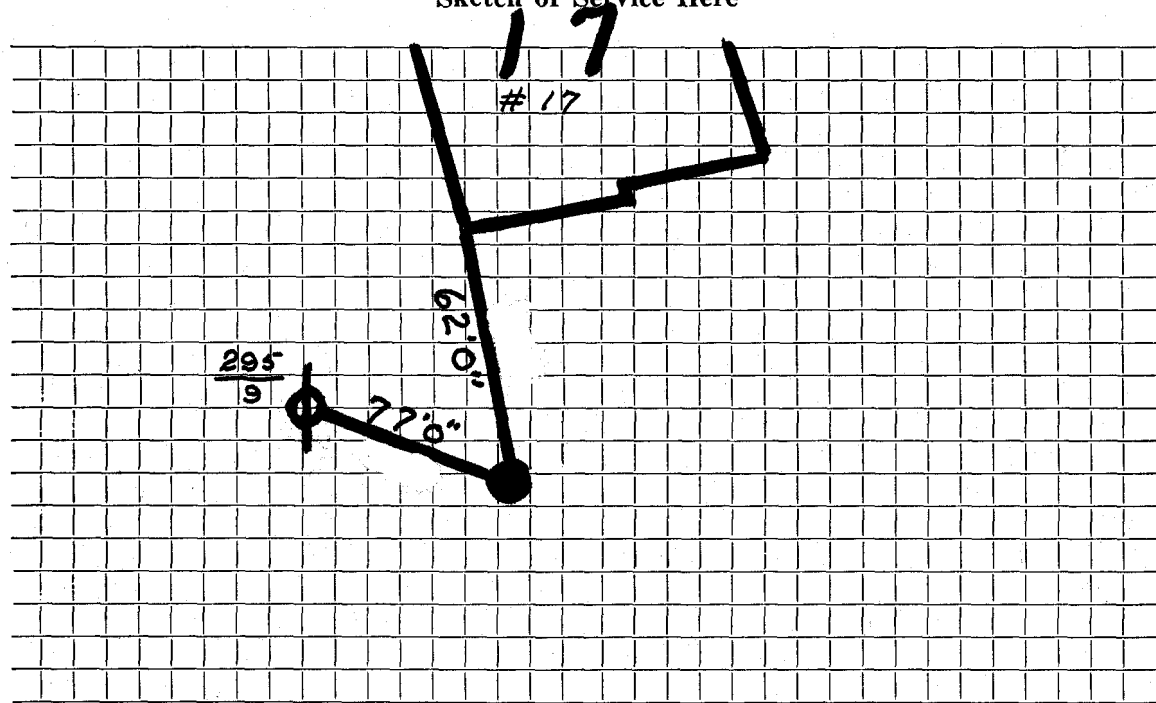

Connection made in Street. Work completed

Remarks:

.....

.....