

WATER SERVICE RECORD

Name DeVries Const. Co., Inc.

Service No. 47

Address 18 Whipple Road

Location

1751, 7636

~~Repair/ Renewal~~ - New Service

Com. 6-13-55


Date	Material	Amount	Total	Date	Amount
4/29/55	Labor	1 85		3-2-55	Deposited 35 00
	10% overhead	19	2 04	6-13-55	Refunded 6 18
	55' - 3/4" copper tubing@.3693	20 31			<u>NON CHARGE</u> 28 82
	1 - 3/4"C x 1/2 I.W.H. stop & waste	4 00	4 00	4/29/55	Labor 3 70
	1 - 3/4"C union		1 72		20' - 3/4" copper tubing@.3693 7 38
	1 hr. trucking		75		1 - 3/4"C corp-cock 4 33
			28 82		1 - 3/4"C curb-cock 4 67
	TRENCH DUG BY OWNER:				1 box and rod 3 90
					1 - 1/2 straight tail pc. 50
					1 - 1/2 offset tail pc. 50
					1 hr. trucking 75
					<u>25 73</u>

DATE _____

TOWN OF LEXINGTON — BOARD OF PUBLIC WORKS

WATER DIVISION

Sketch of Service Here

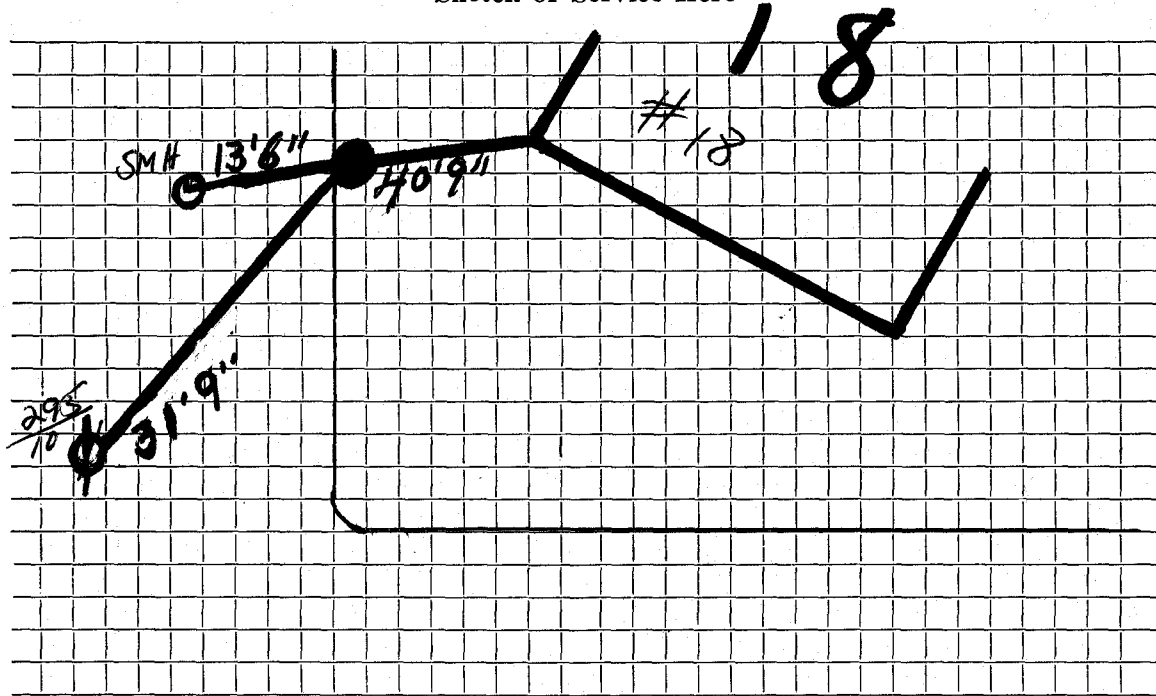

Connection made in Street. Work completed

Remarks:
.....
.....