

#4499

**WATER SERVICE RECORD**

Name Devries Construction Company

Service No. 48

Address 19 Whipple Road

#6963

Location

~~Repair~~ ~~Renewal~~ New Service

*Com 8-15-55*

Date	Material	Amount	Total	Date	Amount
5/6/55	Labor	1 85		3-2-55	23 00
	10% Overhead	19	2 04	8-15-55	6 75
	90' - 3/4" Copper tubing @ .3693	33 24			41 75
	1 - 3/4" C x 1/2 I.W.H. stop & waste	4 00			
	1 - 3/4 C x 3/4 C. union 3pts.	1 72		5/6/55	Labor 2 75
	1 hr. trucking		75	14' - 3/4" Copper tubing @ .3693	5 17
			41 75	1 - 3/4 C. corp-cock	4 33
				1 - 3/4" C x 3/4 C. curb-cock	4 67
				1 box and rod	3 90
	TRENCH DUG BY OWNER			1 - 1/2 offset tail piece	50
				1 - 1/2 straight tail piece	50
				1 hr. trucking	75
					<u>22 57</u>

*Deposited*  
*Paid*


NON CHARGE

DATE \_\_\_\_\_

# TOWN OF LEXINGTON — BOARD OF PUBLIC WORKS

## WATER DIVISION

Sketch of Service Here

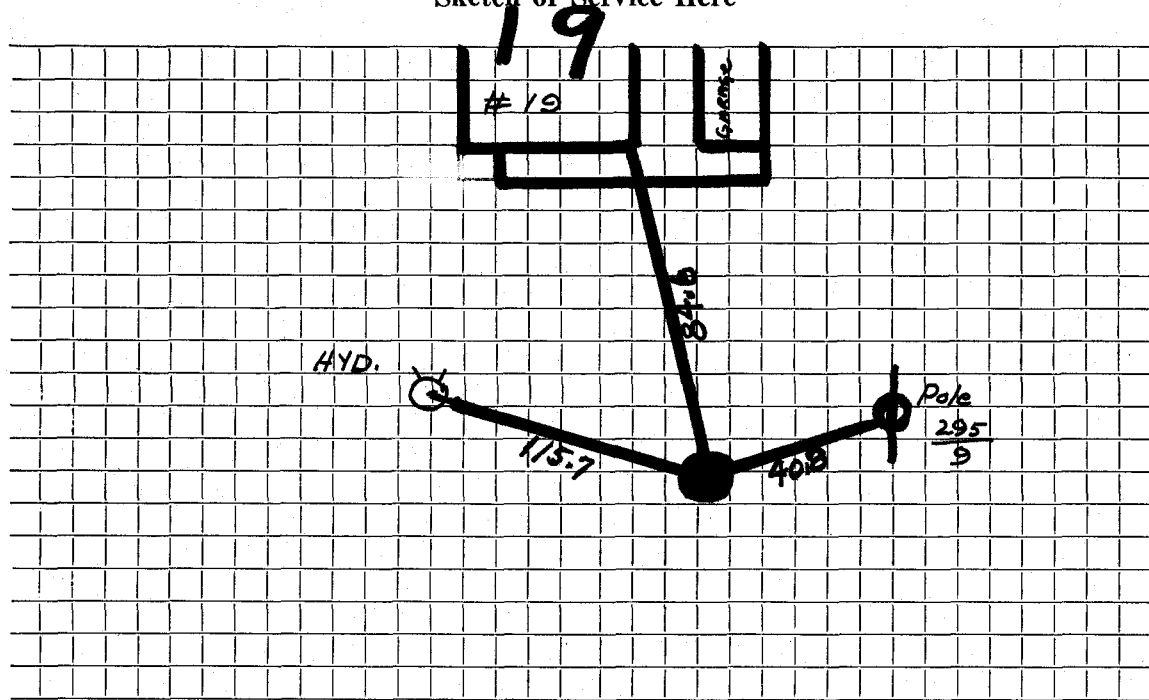

Connection made in ..... Street. Work completed .....

Remarks: .....

.....

.....