

WATER SERVICE RECORD

Name DeVries Const. Company

Service No. 140

Address 20 Whipple Road

Location

~~Repair & Renewal~~ - New Service

Comm. 11-18-57

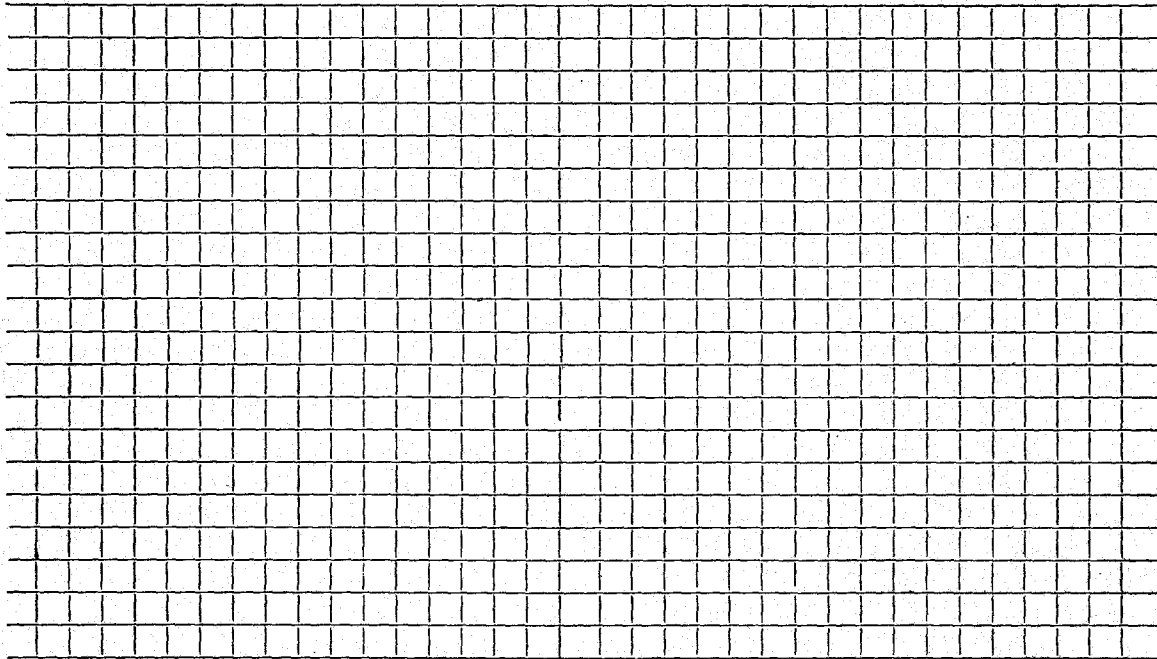
Date	Material	Amount	Total	Date	Amount
7/19/57	Labor	2 04		7-19-57	Deposit \$ 10 00
	10% overhead	20		11-18-57	Refund \$ 2 05
			2 24		\$ 7 95
	owner's copper				
	1 3/4" Cx 1/2 IWH stop & waste		4 96		
	1 hr trucking @ .75		75		
			7 95		
					1 1/2 straight tail pc. 50
					1 1/2 offset tail pc. 50

DATE _____

TOWN OF LEXINGTON — BOARD OF PUBLIC WORKS

WATER DIVISION

Sketch of Service Here

A large grid of graph paper, consisting of 20 columns and 20 rows of small squares, intended for sketching service details.

Connection made in Street. Work completed

Remarks:
.....
.....