

WATER SERVICE RECORD

4949
4950

Name Devries Const. Company

Service No. 169

Address 21 Whipple Road

Location

~~Repair~~ ~~Renewal~~ ~~New Service~~

Com. 8-15-55


Date	Material	Amount	Total	Date	Amount
5/6/55	Labor	1 85		6-6-55	Deposited 225 00
	10% Overhead	19	2 04	8-15-55	Refunded 2 49
	65' - 3/4" Copper tubing @.3693		24 00		<u>NON CHARGE</u> 37 51
	1 - 3/4" C x 1/2" I.W.H. stop & waste		4 00	5/6/55	Labor 2 75
	1 - 3/4" C x 3/4" C. Union		3 pts 1 72	15' - 3/4" Copper tubing @.3693	5 54
	1 hr. trucking		75	1 - 3/4" C. corp-cock	4 33
			32 51	1 - 3/4" C. curb-cock	4 67
	TRENCH DUG BY OWNER			1 box and rod	3 90
				1 - 1/2" offset tail piece	50
				1 - 1/2" straight tail piece	50
				1 hr. trucking	75
					<u>22 94</u>

DATE _____

TOWN OF LEXINGTON — BOARD OF PUBLIC WORKS

WATER DIVISION

Sketch of Service Here

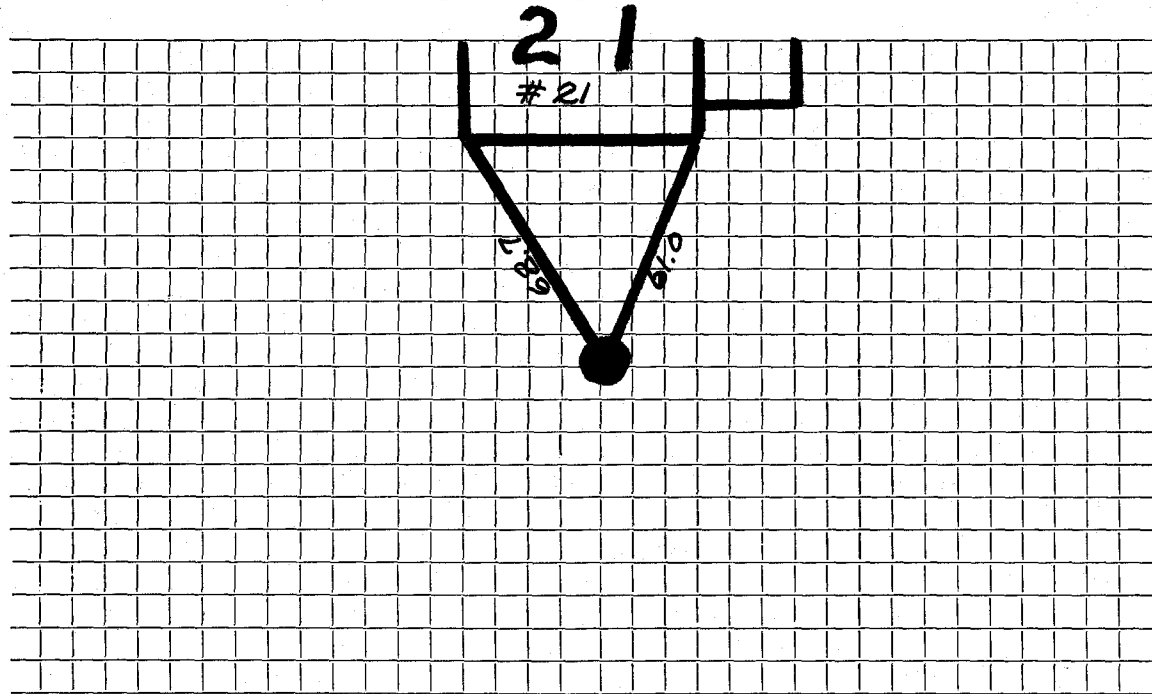

Connection made in Street. Work completed

Remarks:
.....
.....

1206

Name Devries Const. Co. WATER SERVICE RECORD

Service No. 170

Address 23 Whipple Road

Location

Repair/Renewal - New Service

Con. F-15-55

Date	Material	Amount	Total	Date	Amount
5/31/55	Labor	1 85		6-6-55	25 00
	10% Overhead	19	2 04	8-15-55	10 44
	100' - 3/4" Copper tubing @ .3693	36 93	36 93		45 44
	1 - 3/4" C x 1/2 I.W.H. stop & waste	4 00	4 00	5/31/55	5 27
	1 - 3/4" C. union 3 pts.		1 72	20' - 3/4" Copper tubing @ .3693	7 39
	1 hr. trucking		75	1 - 3/4" C. curb-cock	4 33
			45 44	1 - 3/4" C x 3/4" C. curb-cock	4 67
	TRENCH DUG BY OWNER			1 box and rod	3 90
				1 - 1/2 offset tail piece	50
				1 - 1/2 straight tail piece	50
				1 hr. trucking	75
					27 31


Deposited
Paid

NON CHARGE

DATE _____

TOWN OF LEXINGTON — BOARD OF PUBLIC WORKS

WATER DIVISION

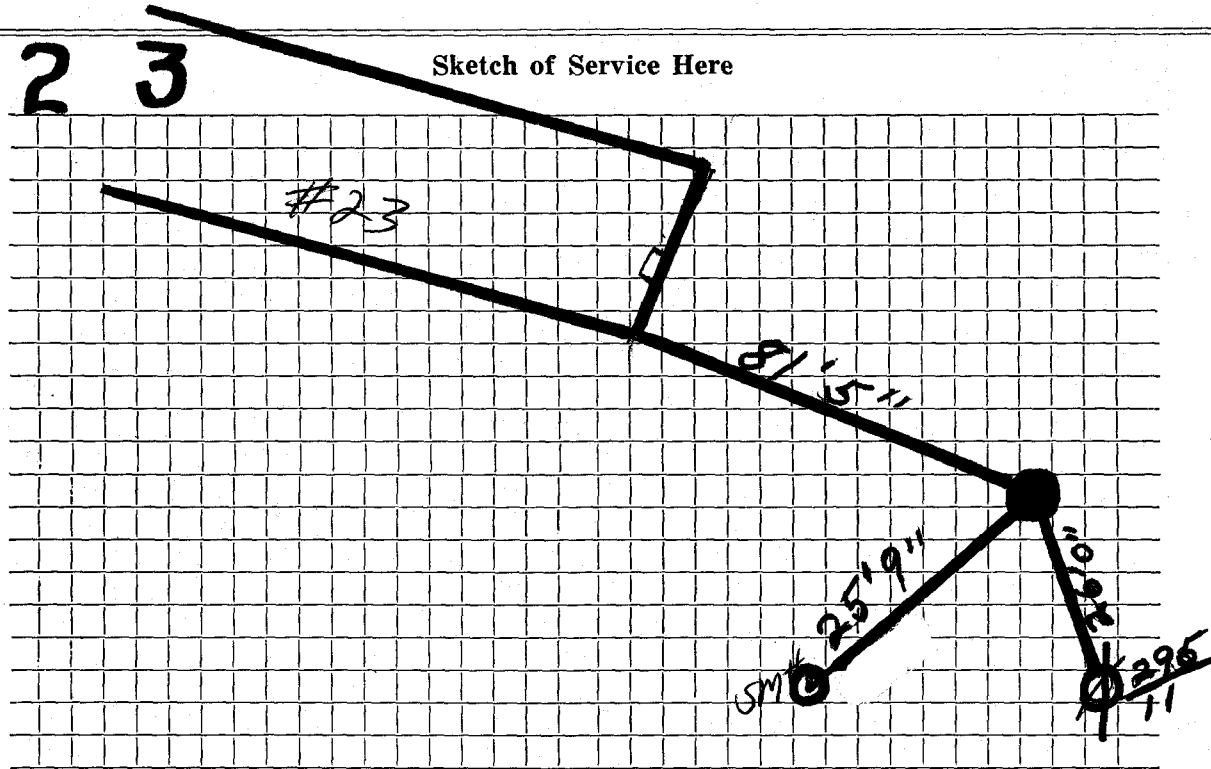

Connection made in Street. Work completed

Remarks:

.....

.....