

WATER SERVICE RECORD

Name DeVries Const. Co.

Service No. 141

Address 27 Whipple Road

Location Lot #183 House # 27

~~Repair~~ Removal - New Service to curb

Comm. 11-18-57


Date	Material	Amount	Total	Date	Amount	
7-19-57	Labor	2 04		7-19-57	Deposit	\$ 10 00
	10% overhead	20		11-18-57	Refund	2 05
			2 24			\$ 7 95
	Owner's copper		-		NON CHARGE	
	1 3/4" C x 1/2" IWH stop & waste		4 96	12-20-56	Labor	5 53
	1 hr trucking		75		17' 3/4" Copper tubing @ .4396	7 47
			7 95		1 3/4" C Corp Cock	4 64
					1 3/4" C Curb Cock	5 94
					1 Box & Rod	4 62
					1 hr. Trucking @ .75	75
						28 95
					1 # straight tl.pc.	50
					1 # offset tail pc.	50
						29 95

DATE _____

TOWN OF LEXINGTON — BOARD OF PUBLIC WORKS

WATER DIVISION

Sketch of Service Here

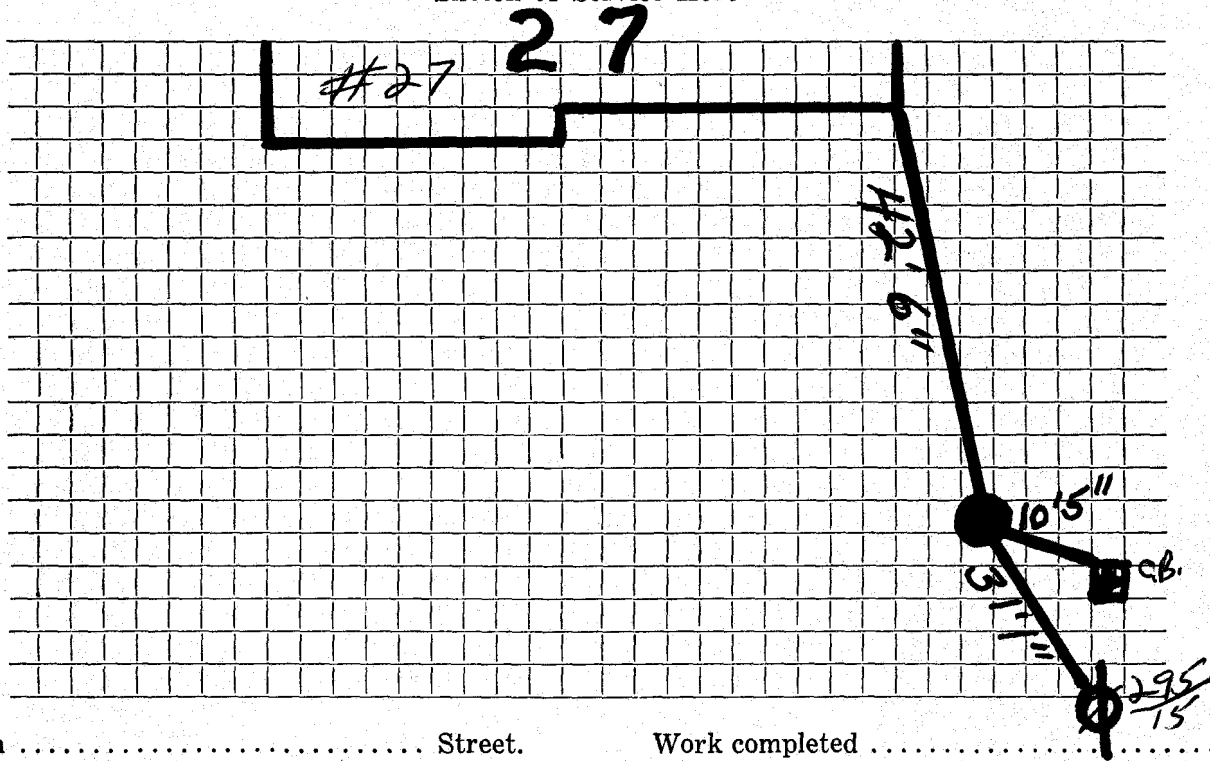

Connection made in Street. Work completed

Remarks:
.....
.....