

## WATER SERVICE RECORD

# 4259

Name DeVries Construction Company

Service No. 33 N. D.

Address ~~xxxxxx Road~~ 28 Whipple Road

Location

~~Repair - Renewal~~ New Service  
XXXXXXXXXXXX

Comm. 4/1/57

Date	Material	Amount	Total	Date	Amount
11-26-56	Labor	1.95			
	10% O. H.	.20	2.15		
1	3/4" C x 1/2 I.W.H. Stop & Waste		4.96		
1	hr. Trucking @.75		.75		
	(Owner's Copper)		7.86		
					NON CHARGE
					Labor
					1.95
					30' 3/4" Copper tubing @.4396
					13.19
					1 3/4" C Corp Cock
					4.64
					1 3/4" C Curb Cock
					5.94
					1 Box & Rod
					4.62
					1 1/2 Straight tail piece
					.50
					1 3/4 Offset tail piece
					.50
					31.34


Bill sent 4/3/57

TOWN OF LEXINGTON — BOARD OF PUBLIC WORKS

WATER DIVISION

Sketch of Service Here

28  
#28

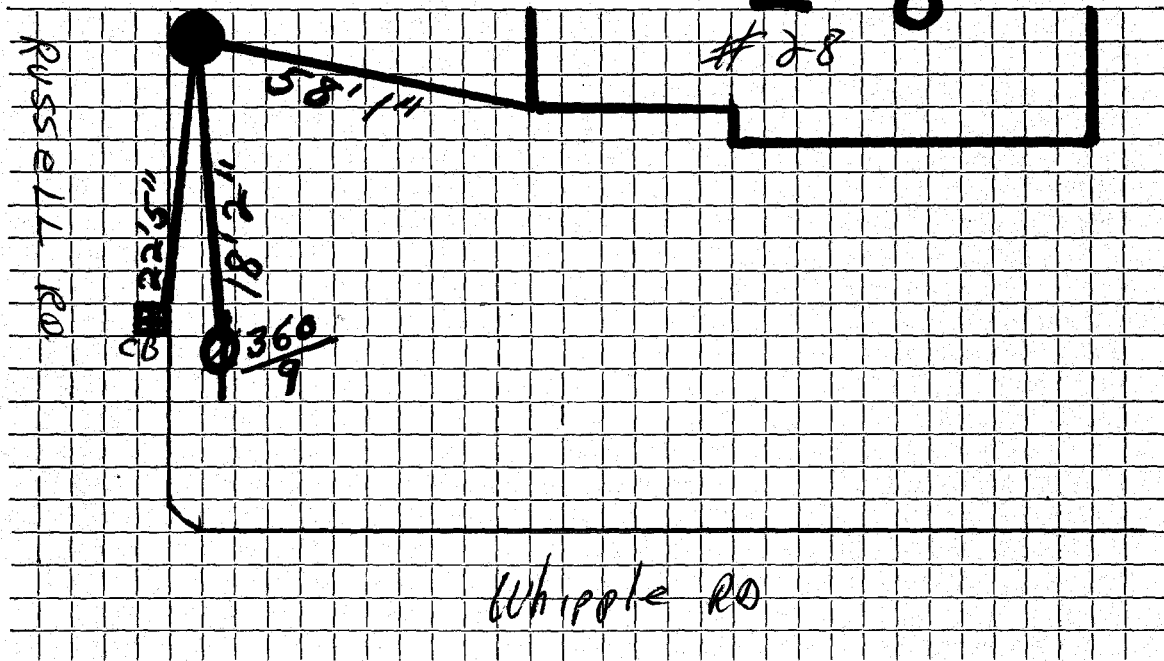

Connection made in ..... Street. Work completed .....

Remarks: .....  
.....  
.....