

## WATER SERVICE RECORD

Name DeVries Const. Company

Service No. 142

Address 29 Whipple Road

Location Lot #184 House # 29

~~REPAIRS~~ New Service to curb

Comm. 11-18-57


Date	Material	Amount	Total	Date	Amount
7/19/57	Labor	2 04		7-19-57	Deposit \$ 10.00
	10% overhead	20		11-18-57	Refund \$ 2.05
			2 24		\$ 7.95
	owner's copper		-		NON CHARGE
	1 3/4 C x 1/2 IWH stop & waste		4 96	12-20-56	Labor 5.53
	1 hr trucking		75		17' 3/4" Copper tubing @ .4396 7.47
			7 95		1 3/4" C Corp Cock 4.64
					1 3/4" C Curb Cock 5.94
					1 Box & Rod 4.62
					1 hr. Trucking @ .75 .75
					28.95
					1 1/2 straight tail pc 50
					1 1/2 offset tail pc. 50
					29 95

DATE \_\_\_\_\_

TOWN OF LEXINGTON — BOARD OF PUBLIC WORKS

WATER DIVISION

Sketch of Service Here

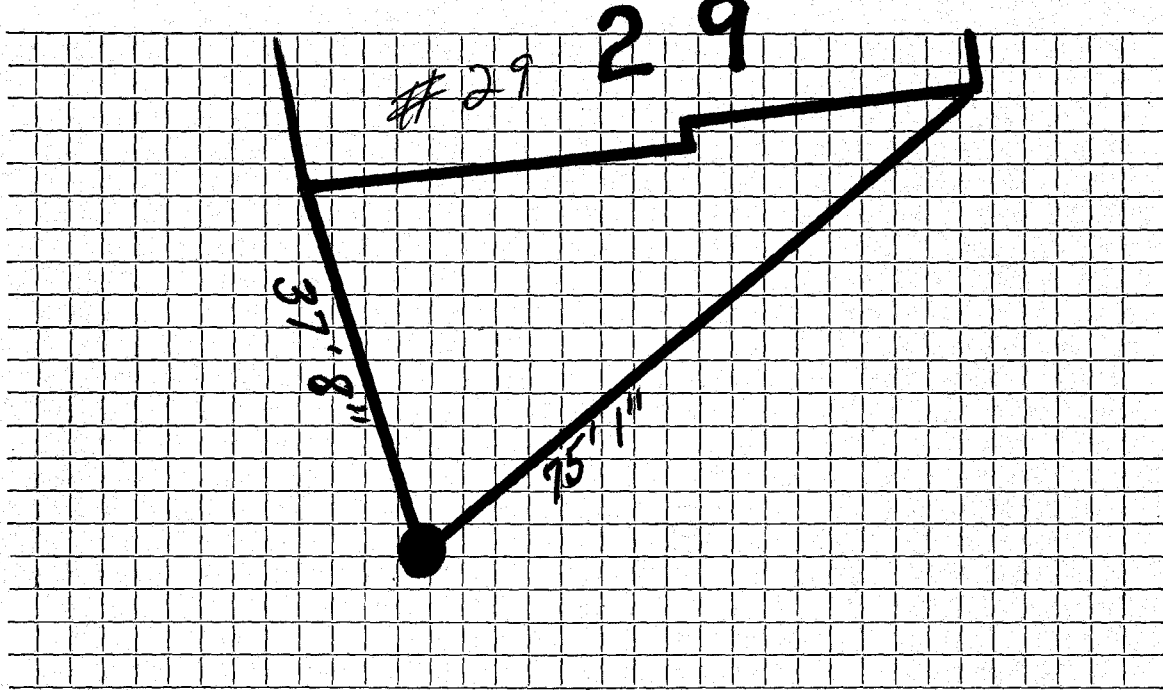

Connection made in ..... Street. Work completed .....

Remarks: .....  
.....  
.....