

WATER SERVICE RECORD

Name DeVries Construction Company

Service No. 143

Address Whipple Road

Location Lot #189 House # 32

~~Repair~~ ~~Renewal~~ ~~New Service~~ to curb
 XXXXXXXXXXXX


Comm. 11-18-57

Date	Material	Amount	Total	Date	Amount
7/19/57	Labor	2 04		7-19-57	Deposit \$ 10.00
	10% overhead	20	2 24	11-18-57	Refund 2.05
	1 - 3/4" Gx 1/2 I.W.H. Stop & Waste		4 96		7.95
	1 hr. Trucking		75		NON CHARGE
			7 95	12-20-56	Labor 5.53
					18' 3/4" Copper tubing @ .4396 7.91
					1 3/4" C Corp Cock 4.64
					1 3/4" C Curb Cock 5.94
					1 Box & Rod 4.62
					1 hr. Trucking @ .75 .75
					29.39
				7/19/57	1 - 1/2 Straight tailpiece .50
					1 - 1/2 Offset tailpiece .50
					1.00

TOWN OF LEXINGTON — BOARD OF PUBLIC WORKS

WATER DIVISION

Sketch of Service Here

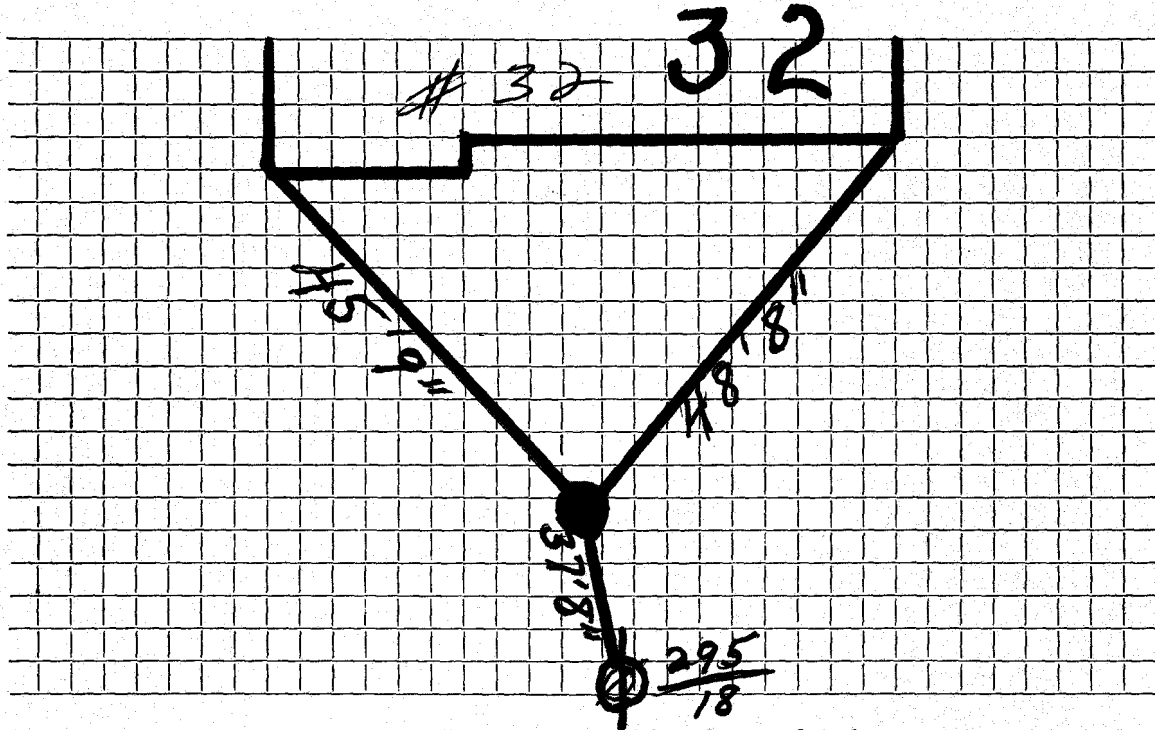

Connection made in Street. Work completed

Remarks:

.....

.....