

#1837

WATER SERVICE RECORD

Name DeVries Construction Company

Service No. 144

Address Whipple Road

Location Lot #186 House # 33

~~REPAIR/RENEWAL~~ New Service to curb


Comm. 11-18-57

Date	Material	Amount	Total	Date	Amount
7/19/57	Labor	2 04		7-19-57	Deposit \$ 10 00
	10% overhead	20	2 24	11-18-57	Refund 2 05
	1 - 3/4" Cx 1/2 I.W.H. Stop & Waste		4 96		7 95
	1 hr. trucking		75		NON CHARGE
			7 95	12-20-56	Labor 5.53
					17' 3/4" Copper tubing @ .4396 7.47
					1 3/4" C Corp Cock 4.64
					1 3/4" C Curb Cock 5.94
					1 Box & Rod 4.62
					22.67
				7/19/57 -	1 Straight tailpiece 50
					1 Offset tailpiece @ 50
					1 00

TOWN OF LEXINGTON — BOARD OF PUBLIC WORKS

WATER DIVISION

Sketch of Service Here

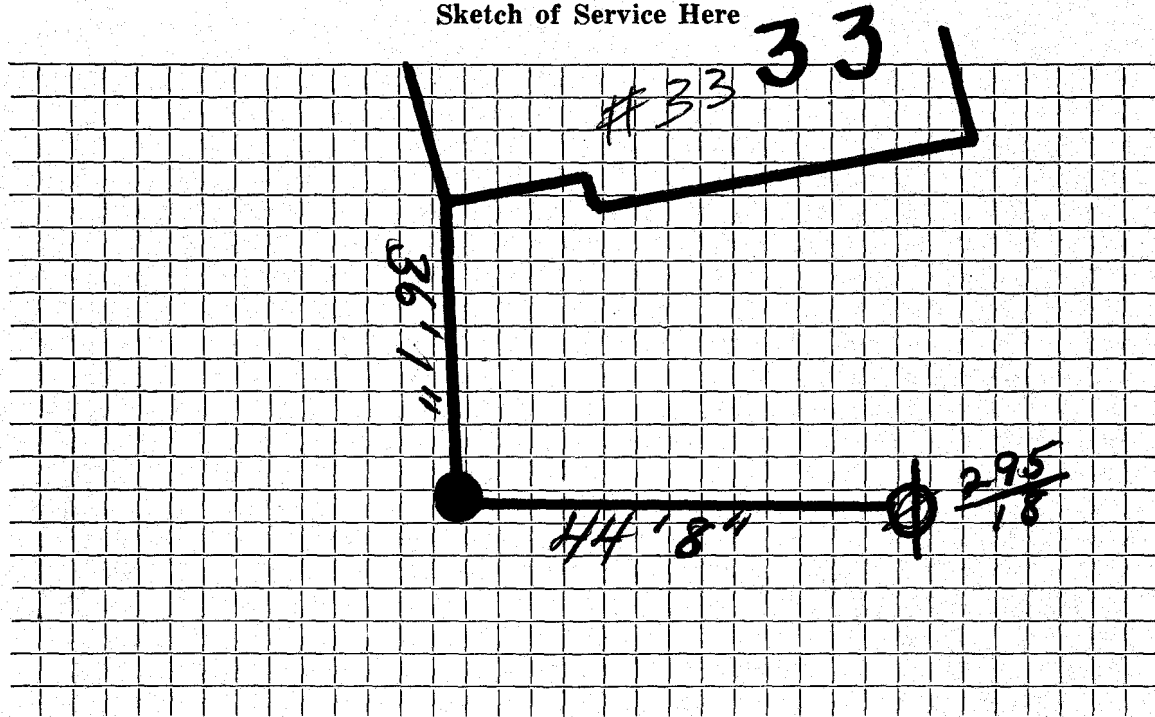

Connection made in Street. Work completed

Remarks:

.....

.....