

WATER SERVICE RECORD

Name DeVries Construction Company

Service No. 146

Address Whipple Road

Location Lot #187 House # 35

~~XXXXXX~~ - New Service to curb

Comm. 11-18-57


Date	Material	Amount	Total	Date	Amount
7/19/57	Labor	2 04		7-19-57	Deposit \$ 10 00
	10% overhead	20	2 24	11-18-57	Refund 2 00
	1 - 3/4" Cx 1/2 I.W.H. Stop & Waste		4 96		7 00
	1 hr. trucking		75		NON CHARGE
			7 95	12-20-56	Labor 5.53
					8' 3/4" Copper tubing @ .4396 3.52
					1 3/4" C Corp Cock 4.64
					1 3/4" C Curb Cock 5.94
					1 Box & Rod 4.62
					24.25
				7/19/57	1 - 1/2 Straight tailpiece 50
					1 - 1/2 Offset tailpiece 50
					1 00

DATE _____

TOWN OF LEXINGTON — BOARD OF PUBLIC WORKS

WATER DIVISION

Sketch of Service Here

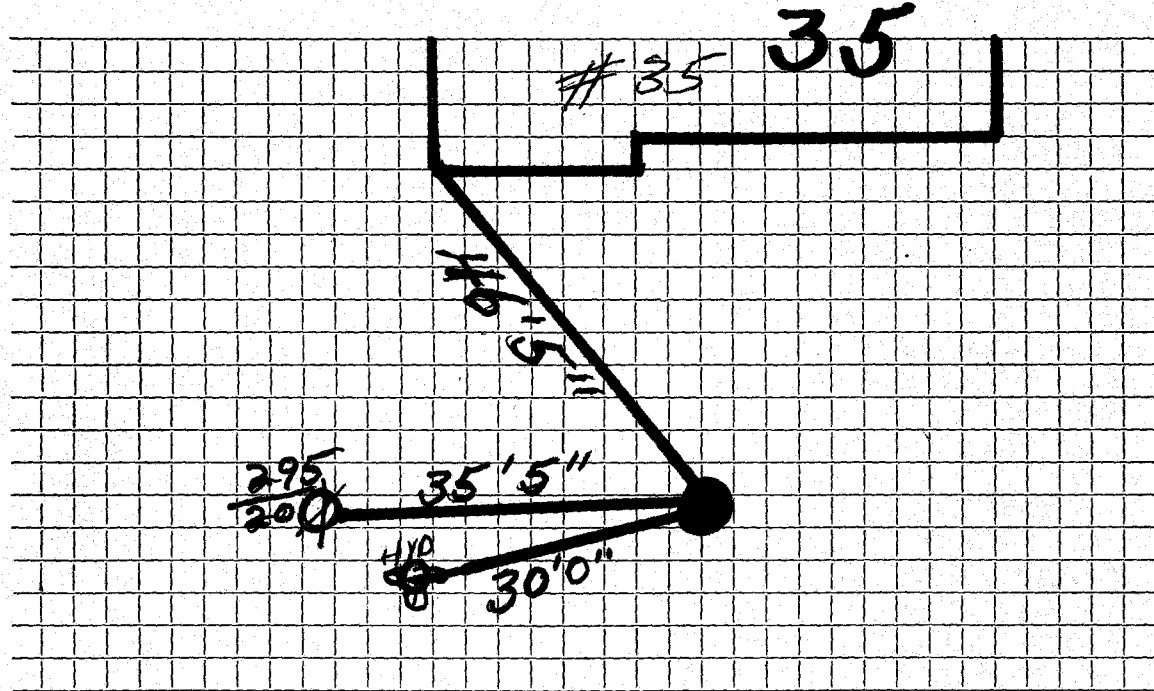

Connection made in Street. Work completed

Remarks:

.....

.....