

WATER SERVICE RECORD

Name DeVries Const. Co.

Service No. 43

Address 7 Whipple Road

Location

~~REPAIR WORK~~ - New Service *Com. 3-21-55*


Date	Material	Amount	Total	Date	Amount
2/25/55	Labor	1 85		3-2-55	Deposited 25 00
	10% overhead	19	2 04	3-21-55	Refunded 7 21
	60' - 3/4" copper tubing@.35	21 00			NON CHARGE 27 79
	1 - 3/4"C x 1/2 I.W.H.stop&waste	4 00		2/25/55	Labor 3 44
	1 hr. trucking		75	15'- 3/4" copper tubing@.35	5 25
			27 79	1 - 3/4"C. corp-cock	4 33
	TRENCH DUG BY OWNER:			1 - 3/4"C. curb-cock	4 67
				1 box and rod	3 90
				1 - 1/2 straight tail pc.	50
				1 - 1/2 offset tail pc.	50
				1 hr. trucking	75
					23 34

DATE \_\_\_\_\_

TOWN OF LEXINGTON — BOARD OF PUBLIC WORKS

**WATER DIVISION**

Sketch of Service Here

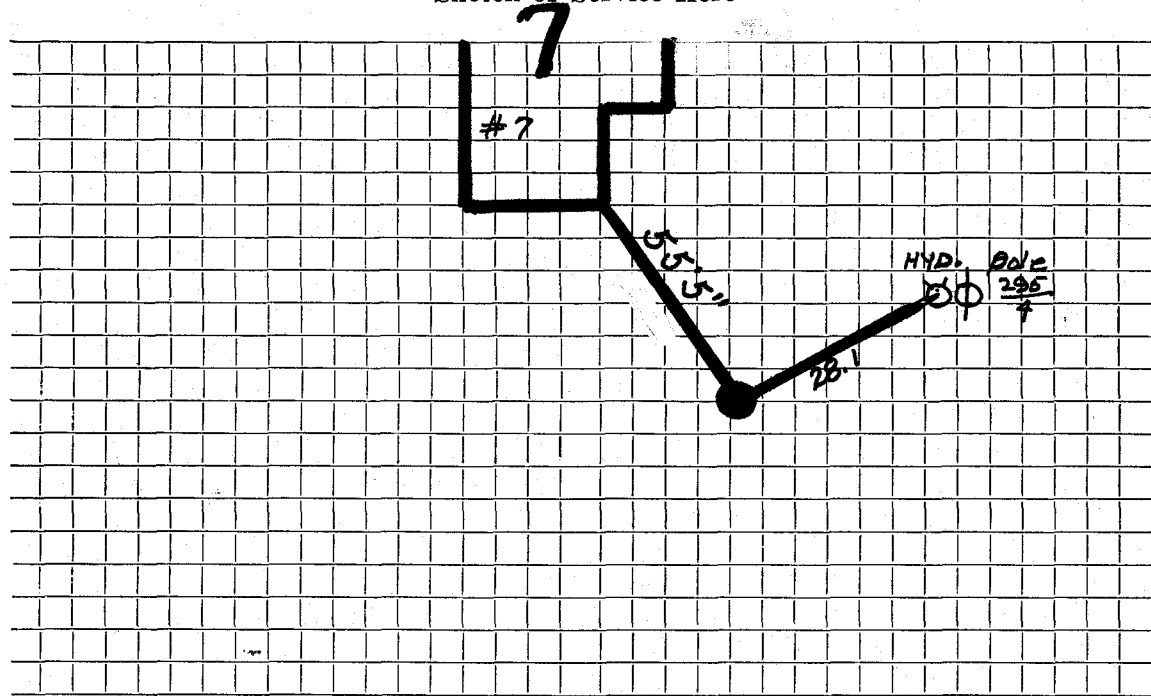

Connection made in ..... Street. Work completed .....

Remarks: .....

.....

.....