

WATER SERVICE RECORD

Name DeVries Const. Co.

Service No. 44

Address 9 Whipple Road

#7340

Location

~~REPAIR~~ ~~RENEW~~ New Service

*Com. 3-21-55*


Date	Material	Amount	Total	Date	Amount
2/23/55	Labor	1 85		3-2-55	25 00
	10% overhead	19	2 04	3-21-55	( 7 21
	60' - 3/4" copper tubing@.35		21 00		NON CHARGE
	1 - 3/4"C x 1/2 I.W.H. stop& waste		4 00	2/23/55	Labor
	1 hr. trucking		75		20' - 3/4" copper tubing@.35
			27 79		1 - 3/4"C. corp-cock
	TRENCH DUG BY OWNER:				1 - 3/4"C. curb-cock
					1 box and rod
					1 - 1/2" straight tail piece
					1 - 1/2" offset tail piece
					1 hr. trucking
					75
					25 15

DATE \_\_\_\_\_

TOWN OF LEXINGTON — BOARD OF PUBLIC WORKS

WATER DIVISION

Sketch of Service Here

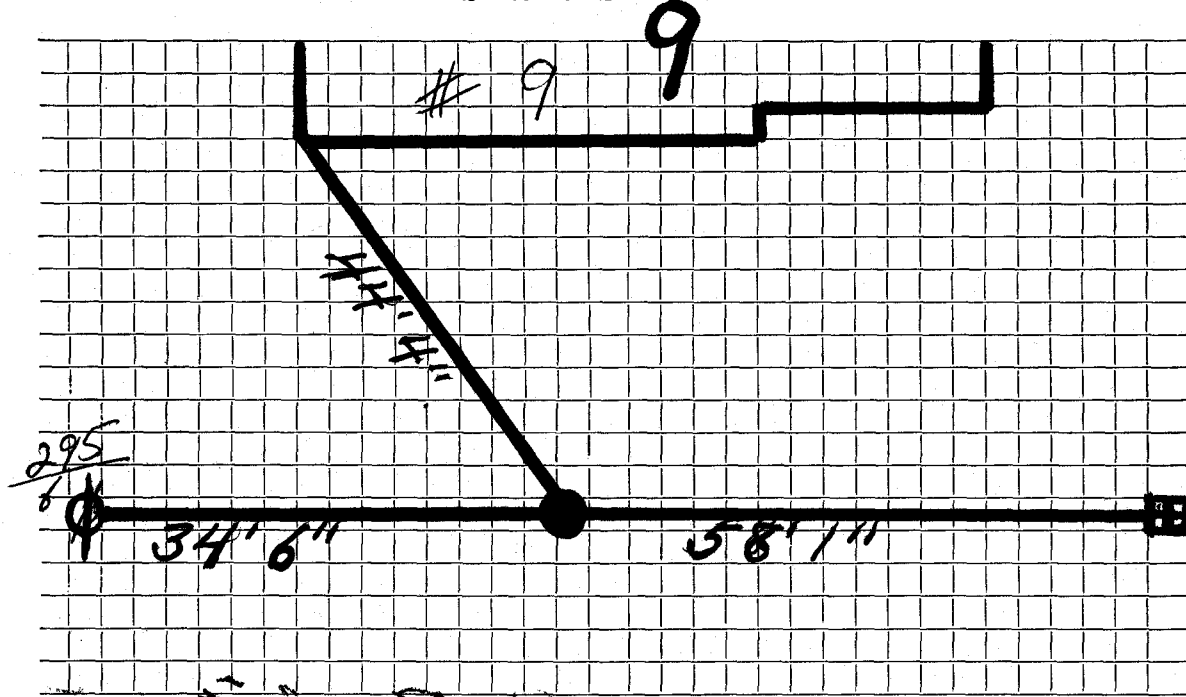

Connection made in ..... Street. Work completed .....

Remarks: .....

.....

.....