

WATER SERVICE RECORD

1587

Name James W. Ritchie

Service No. 38

Address 1 Whipple Road

Location

Repair—Renewal—New Service

W.O. #7068 Sibley #1116

NOV 18 1968


Date		Material	Amount		Total		Date	Amount
7/24/68		Labor	11	06			7-16-68	175 00
		10% O.H.	1	11	12	17	7-18-68	119 33
	14'	3/4" Copperpipe @ .79			11	06		119 33
		3/4" Curb Stop			8	37		55 77
		3/4" Corporation			9	57		
		Box & Rod			5	10		
	1	Hr. trucking			3	00		
	1	" shovel			6	50		
					55	77		
8-15-68	49'	3/4" Copper Tubing						

DATE _____

TOWN OF LEXINGTON — BOARD OF PUBLIC WORKS

WATER DIVISION

Sketch of Service Here

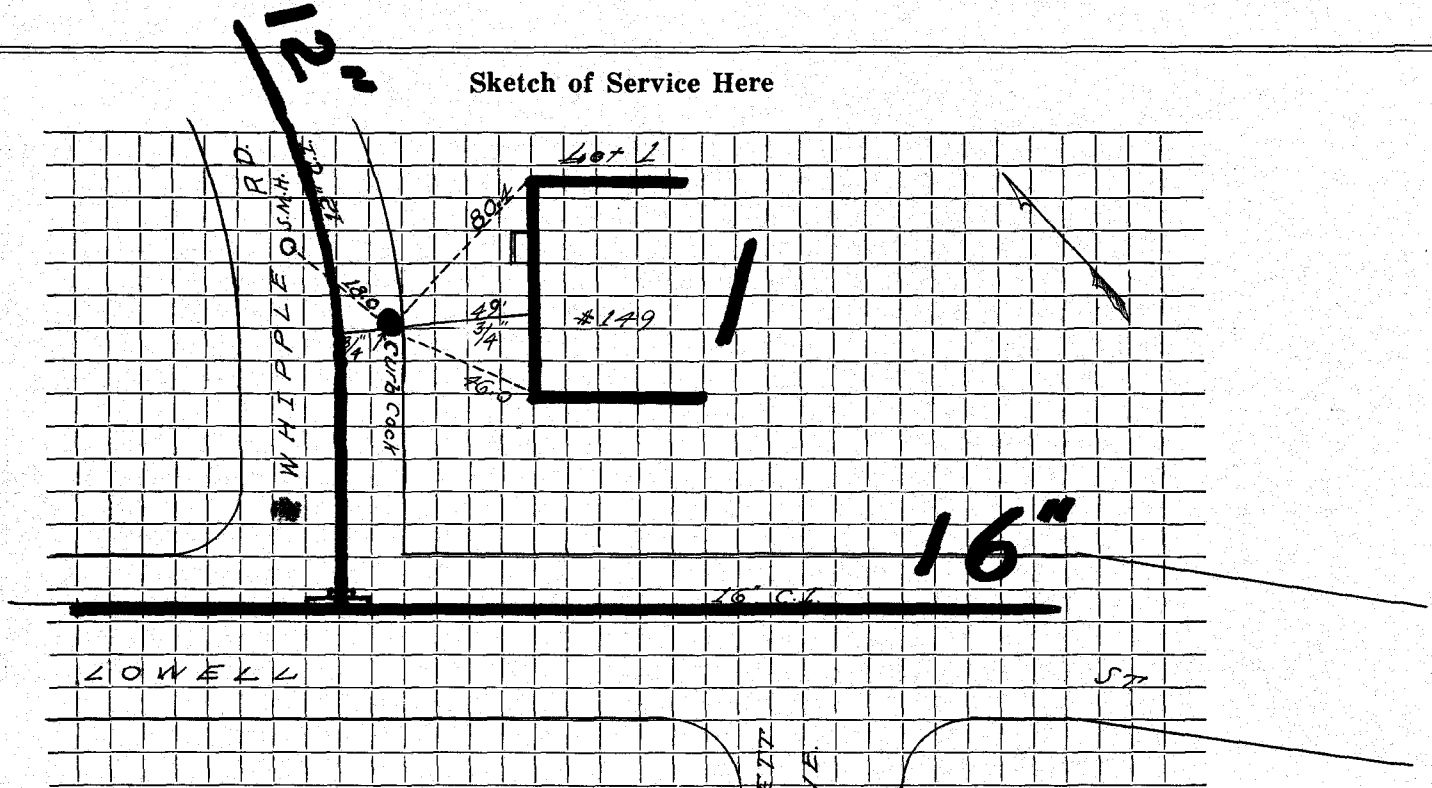

Connection made in Street. Work completed

Remarks:
.....
.....