




DATE 11-20-20

TOWN OF LEXINGTON — BOARD OF PUBLIC WORKS

WATER DIVISION

Sketch of Service Here

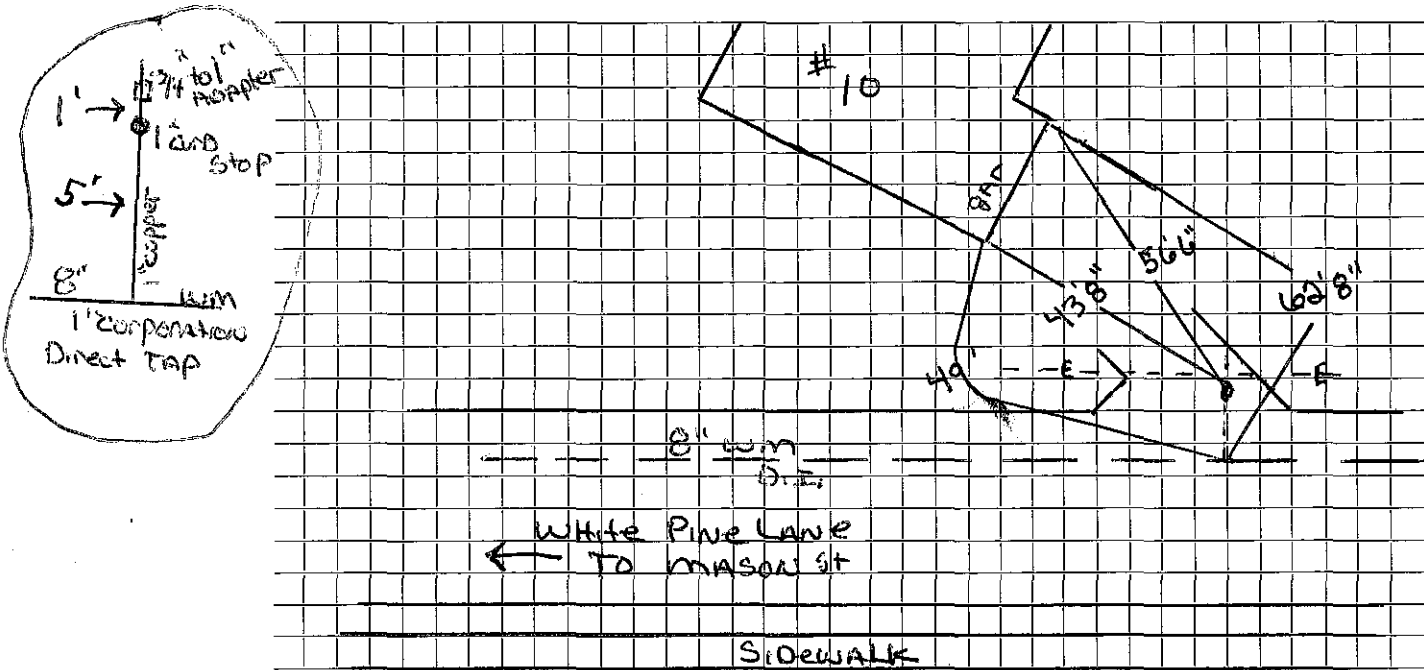

Connection made in ..... Street. Work completed Installed new main to curb stop .....

Remarks: .....

.....

.....