


DATE 11-24-20

TOWN OF LEXINGTON — BOARD OF PUBLIC WORKS
WATER DIVISION

Sketch of Service Here #13

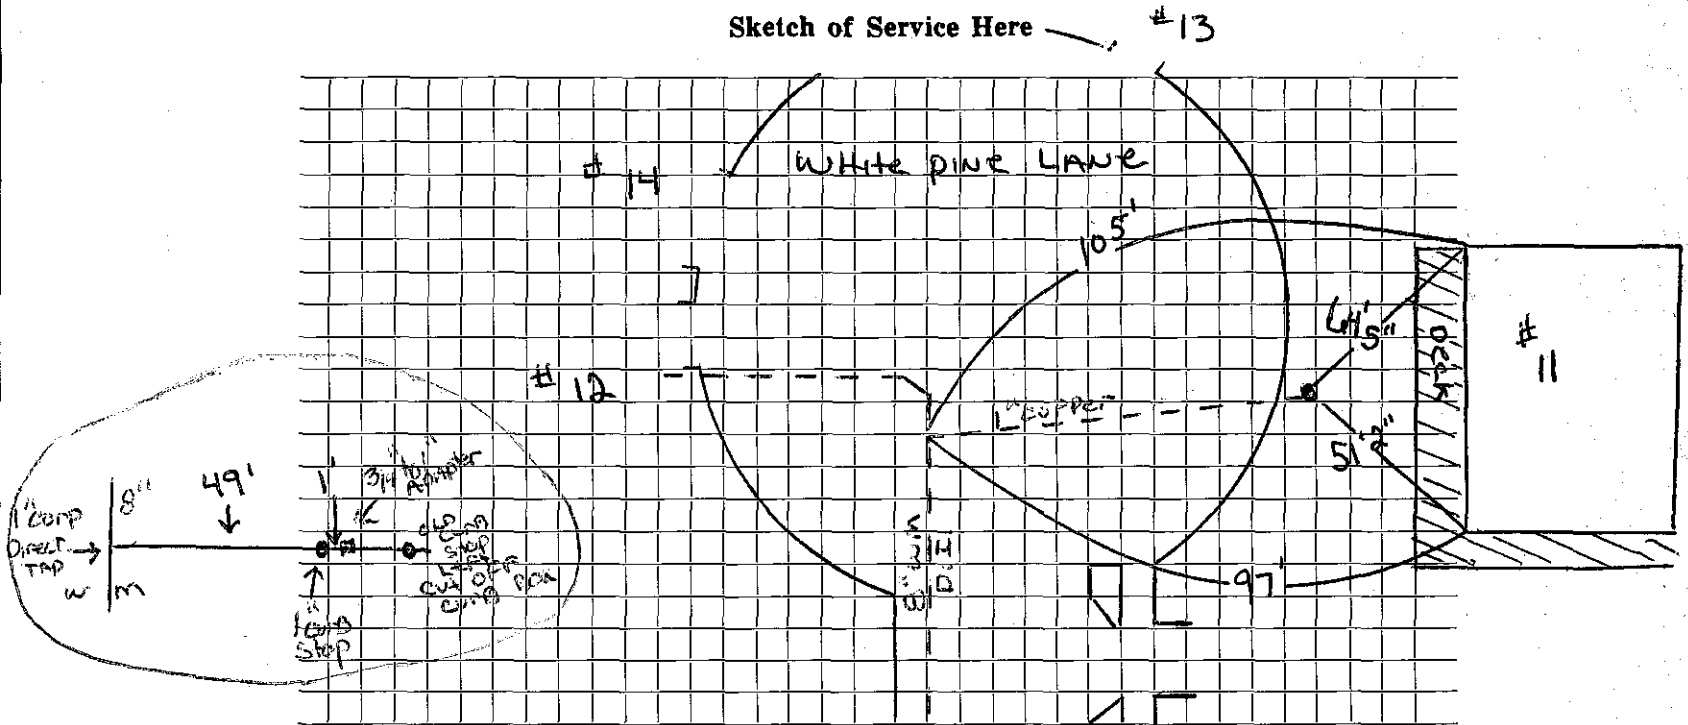

Connection made in Street. Work completed Installed new main to curb stop
Remarks: OLD curb stop was left in place curb box was cut off at 2'