
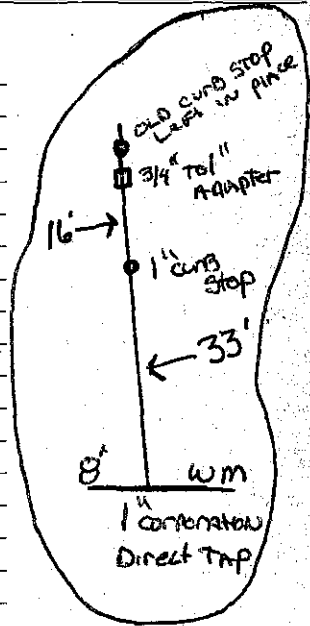


DATE 11-24-20

TOWN OF LEXINGTON — BOARD OF PUBLIC WORKS
WATER DIVISION

Sketch of Service Here

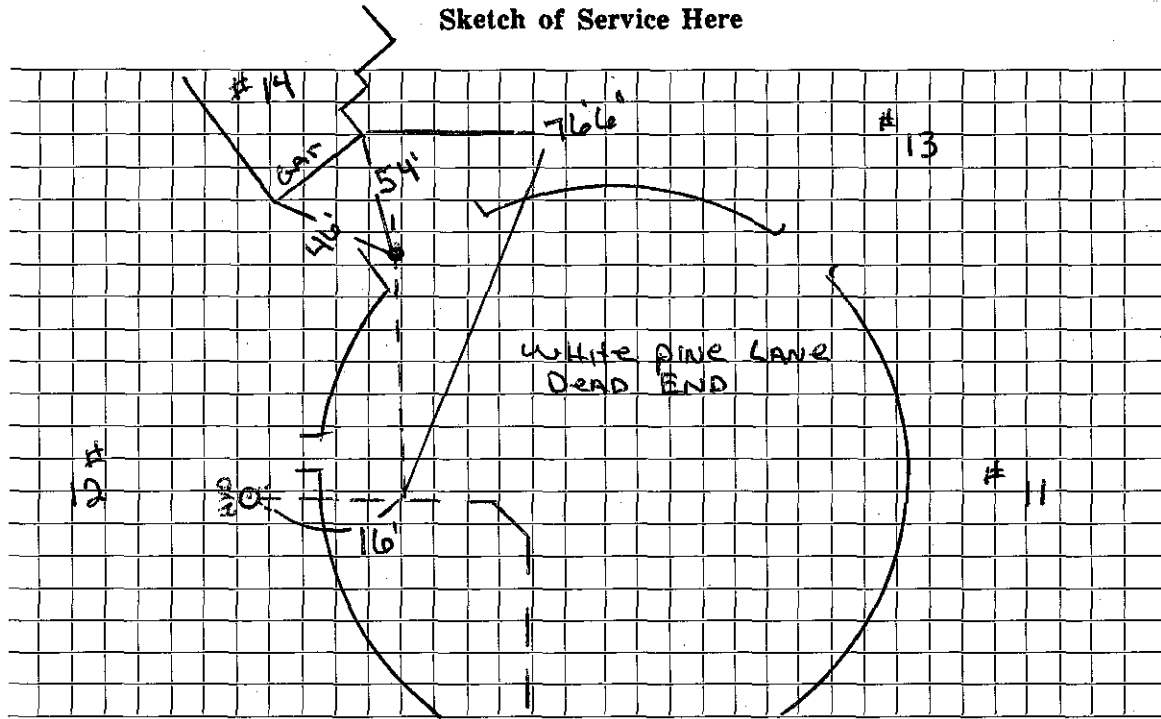

Connection made in Street. Work completed INSTALLED NEW MAIN TO CURB STOP

Remarks: OLD CURB STOP WAS LEFT IN PLACE... REMOVED CURB BOX