





DATE 11-17-20

TOWN OF LEXINGTON — BOARD OF PUBLIC WORKS

WATER DIVISION

Sketch of Service Here

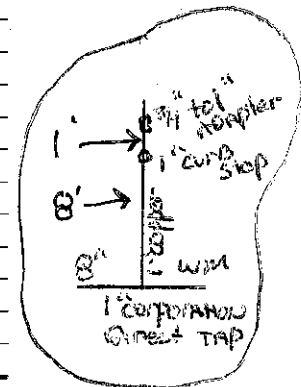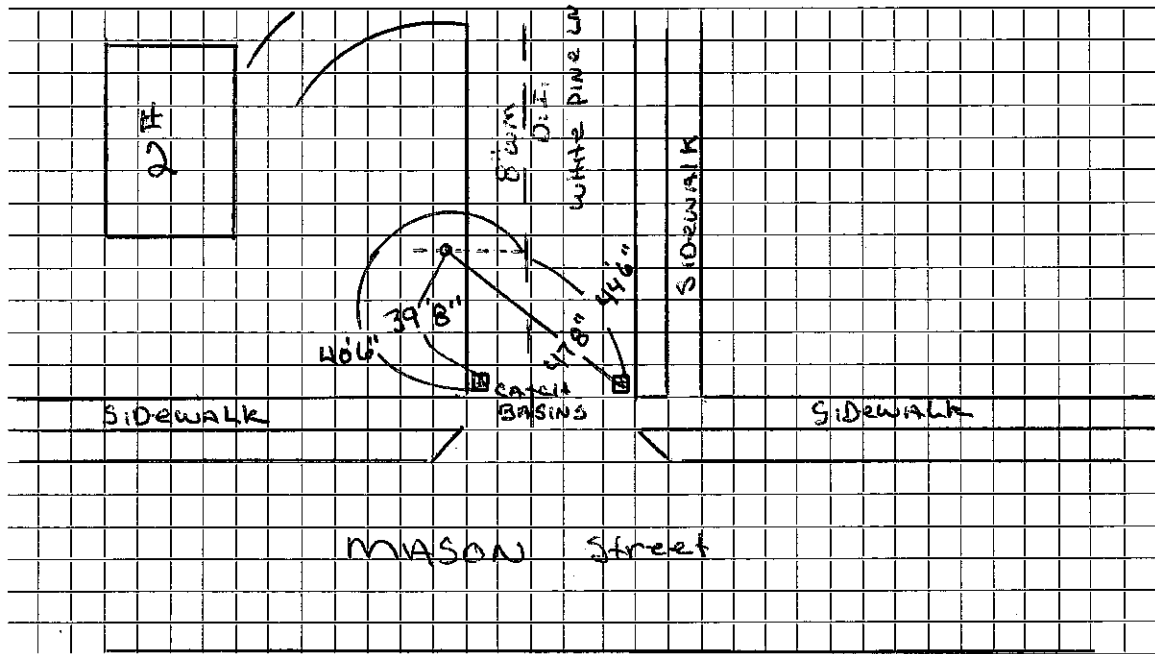

Connection made in White Pine Lane Street.

Work completed Installed new main to curb stop

Remarks: .....

.....

.....