
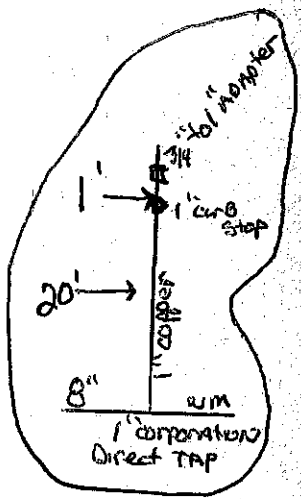


DATE 11-17-20

TOWN OF LEXINGTON — BOARD OF PUBLIC WORKS

WATER DIVISION

Sketch of Service Here

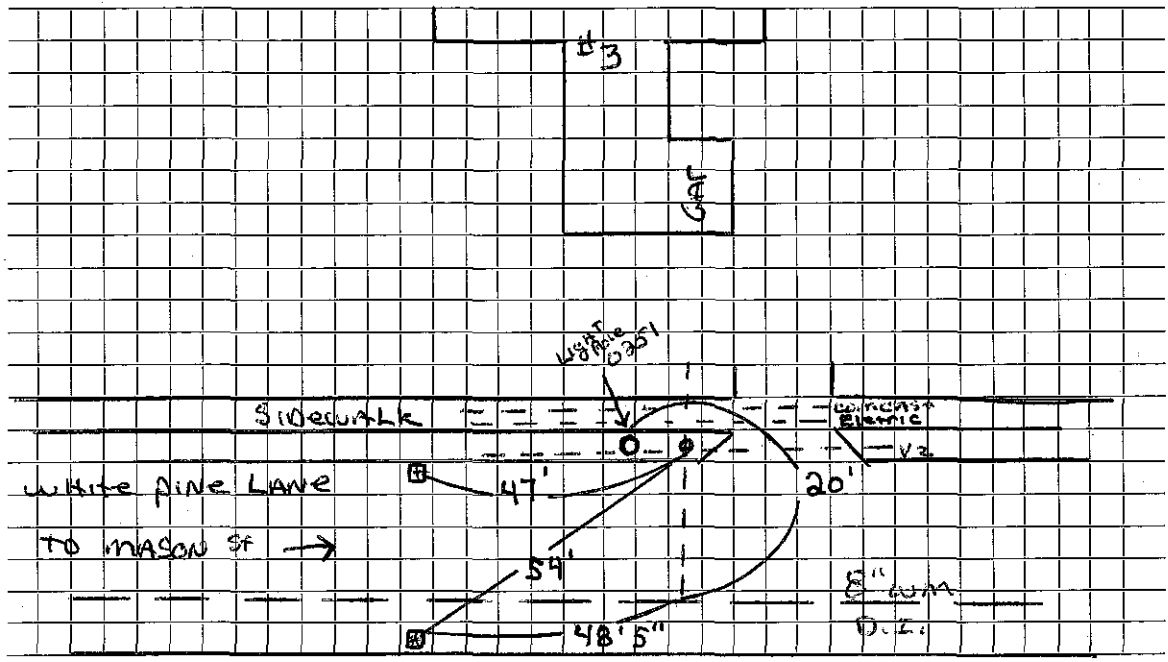

Connection made in Street.

Work completed INSTALLED NEW MAIN TO CURB STOP.

Remarks:

.....

.....