





DATE 11-18-20

TOWN OF LEXINGTON — BOARD OF PUBLIC WORKS

WATER DIVISION

Sketch of Service Here

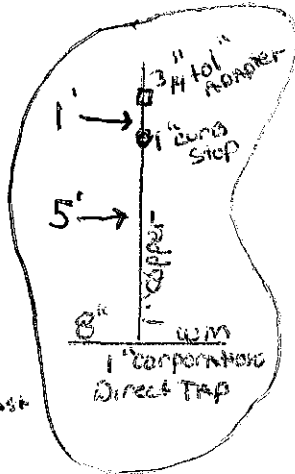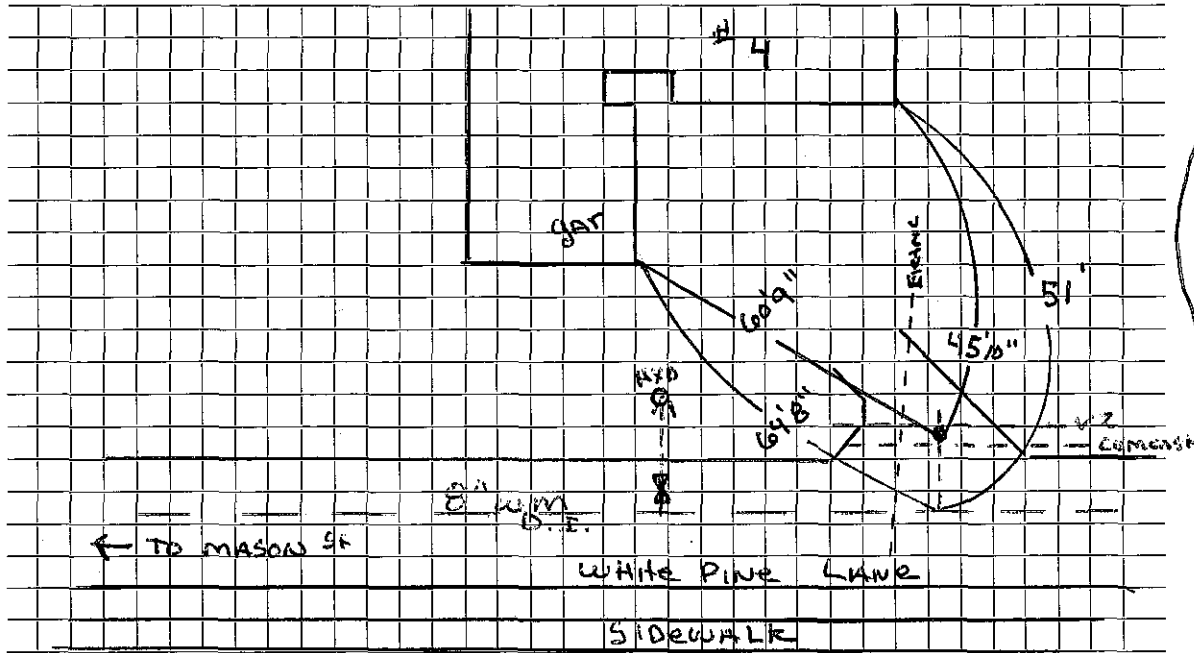

Connection made in ..... Street. Work completed ~~Installed~~ new main to curb Stop..

Remarks: .....

.....

.....