
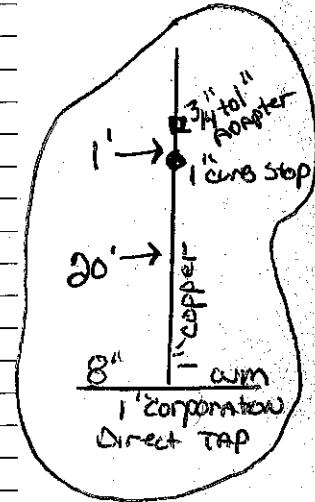


DATE 11-18-20

TOWN OF LEXINGTON — BOARD OF PUBLIC WORKS

WATER DIVISION

Sketch of Service Here

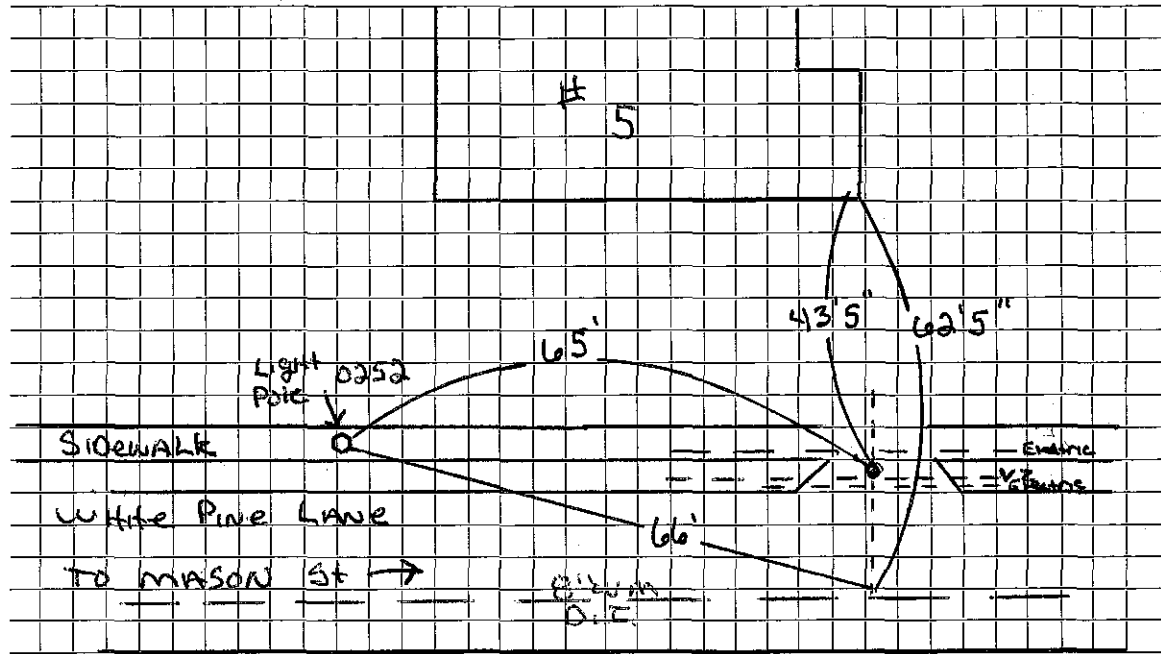

Connection made in Street. Work completed Installed new main to CORB Stop...

Remarks:

.....

.....