
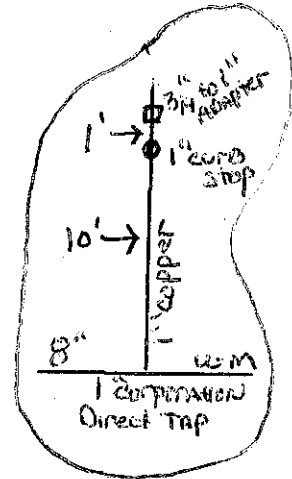


DATE 11-19-20

TOWN OF LEXINGTON — BOARD OF PUBLIC WORKS

WATER DIVISION

Sketch of Service Here

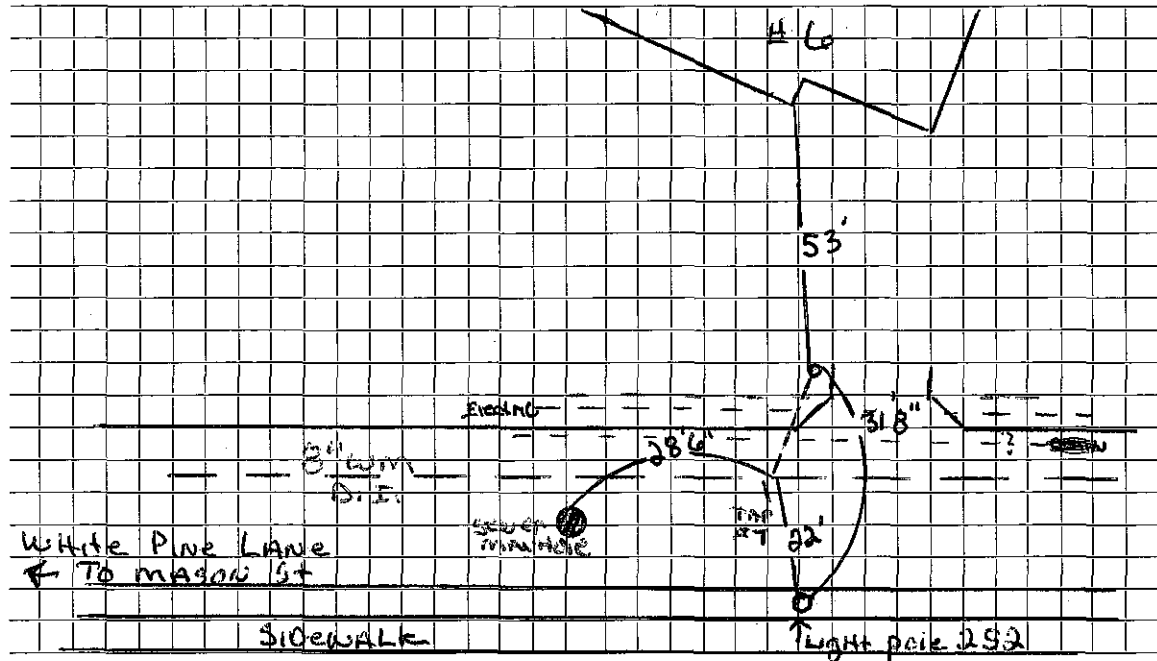

Connection made in Street.

Work completed Installed new main to curb stop.

Remarks:
.....
.....