





DATE 11-19-20

TOWN OF LEXINGTON — BOARD OF PUBLIC WORKS

WATER DIVISION

Sketch of Service Here

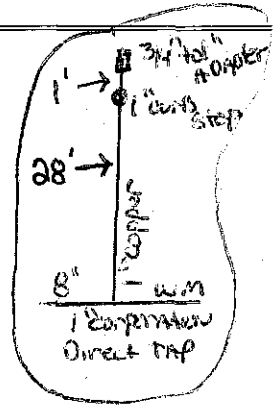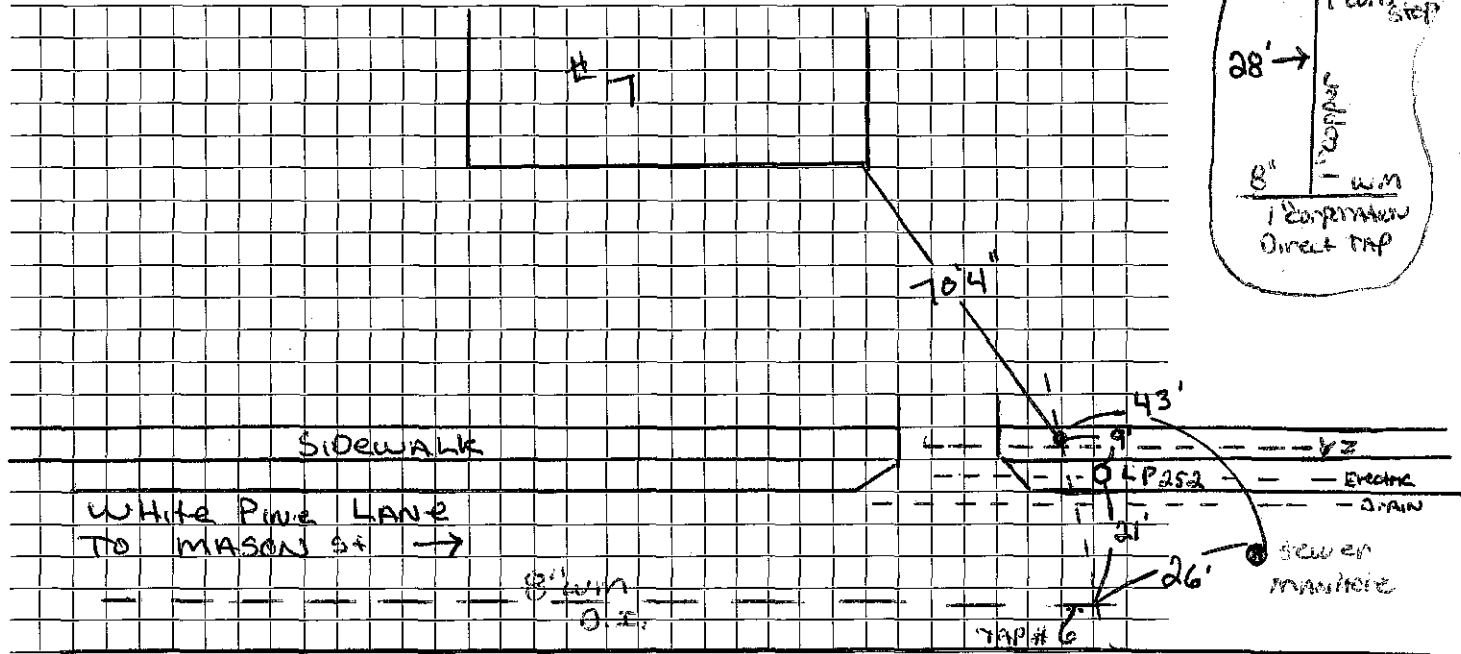

Connection made in ..... Street.

Work completed Installed new main to curb stop

Remarks: .....  
.....  
.....