

WATER SERVICE RECORD

Name Ben Franklin Homes

Service No. 9

Address 2 White Terrace

Location Lot #12 Sta 0+64

~~XXXXXXXXXXXX~~ - New Service No # 7814


Comm 8-26-63

Date	Material	Amount	Total	Date	Amount	
10-1-62	Labor	2.13		4-3-63	Deposit	50.00
	10% O.H.	.21	2.34	8-26-63	Paid by SHC # 216	30.95
	10' 3/4" Copper tubing @.42		4.20			80.95
	BILL WHEN CONNECTED		6.54			
4-10-63	Labor	2.77			NON CHARGE	
	10% O.H.	.28	3.05	10-1-62	Labor	2.13
	138' 3/4" Copper tubing @.42		57.96	24'	3/4" Copper tubing @.42	10.08
	3 3/4" C 3 part union @2.41		7.23	1	3/4" C Corp Cock	4.91
	1 3/4" x 1/2 I.W.H.Stop & Waste		6.17	1	3/4" C Curb Cock	6.28
			80.95	1	Box & Rod	4.90
						28.30
				1	1/2 Straight tailpiece	.50
				1	1/2 Offset tailpiece	.50
						29.30

TOWN OF LEXINGTON — BOARD OF PUBLIC WORKS

WATER DIVISION

Sketch of Service Here

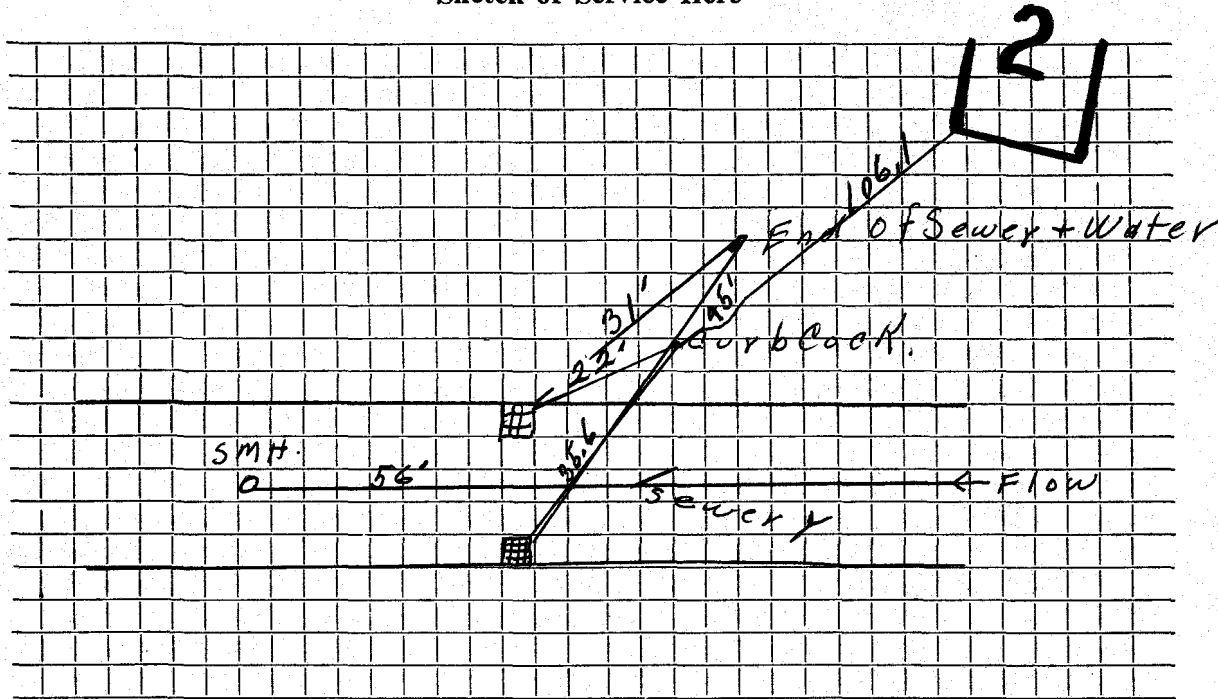

Connection made in ..... Street. Work completed .. 4-10-63 .....

Remarks: ..... Service installed ..... Curb to House by Builder .....