

## WATER SERVICE RECORD

Name Ben Franklin Homes

Service No. 174

Address 3 White Terrace

Location Lot 11 Sta.0+72

~~Revised Invoice~~ - New Service

WO # 2259


Comm 8-26-63

Date	Material	Amount	Total	Date	Amount
	8' 3/4" Copper tubing @.42		3.36	12-6-63	Deposit 25.00
	BILL WHEN CONNECTED			8-26-63	Refund 32.71
4-15-63	65' 3/4" Copper tubing @.42		27.30		42.29
	1 3/4 x 1/2 I.W.H. Stop & Waste		6.17		NON CHARGE
	1 3/4" C 2 part union		2.41	10-1-62	Labor 4.26
	Labor	2.77	27.24		14' 3/4" Copper tubing @.42 5.88
	10% O.H.	.28	3.05		1 3/4" C Corp Cock 4.91
			42.29		1 3/4" C Curb Cock 6.28
					1 Box & Rod 4.90
					26.23
					1 1/2 Straight tailpiece .50
					1 1/2 Offset tailpiece .50
					27.23

TOWN OF LEXINGTON — BOARD OF PUBLIC WORKS

WATER DIVISION

Sketch of Service Here

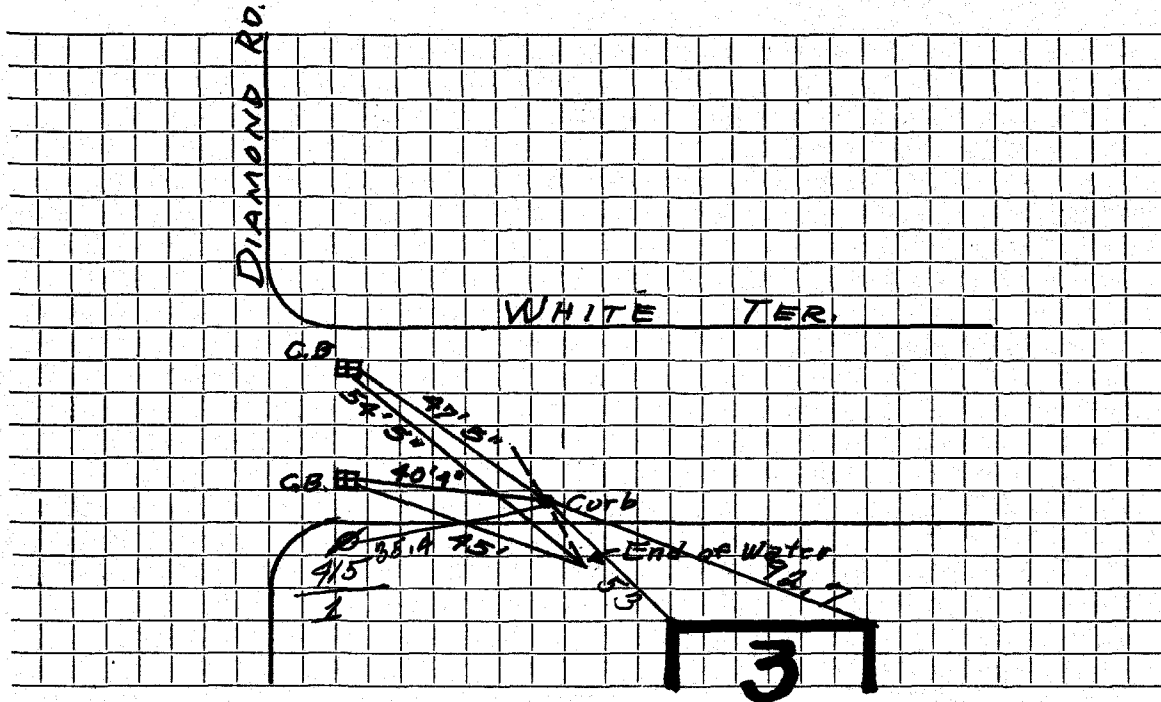

Connection made in ..... Street. Work completed .. 11.5.63 .....

Remarks: ... Service ... installed ... curb ... to ... house ... by ... builder .....