

WATER SERVICE RECORD

Name Benjamin Franklin Homes

Service No. 164

Address 4 White Terrace

2642 - 2443

Location Lot 13 Sta. 2+79


~~Reconnect~~ - New Service WO #7720

Comm 1-14-63

Date	Material	Amount	Total	Date	Amount	
11-15-62	Labor	3.79		11-8-62	Deposit	75.00
	10% O.H.	.38	4.17	1-14-63	Refund	20.25
100	3/4" Copper tubing @.42		42.00			54.75
1	3/4" C x 1/2 I.W.H. Stop & Waste		6.17		NON CHARGE	
1	3/4" C 3 part union		2.41	10-2-62	Labor	2.31
			54.75	25	3/4" Copper tubing @.42	10.50
11-15-62	Labor			1	3/4" C Corp Cock	4.91
				1	3/4" C Curb Cock	6.28
				1	Box & Rod	4.90
						28.90
				1	1/2 Straight tailpiece	5.0
				1	1/2 Offset tailpiece	5.0
						29.90

TOWN OF LEXINGTON — BOARD OF PUBLIC WORKS
WATER DIVISION

Sketch of Service Here

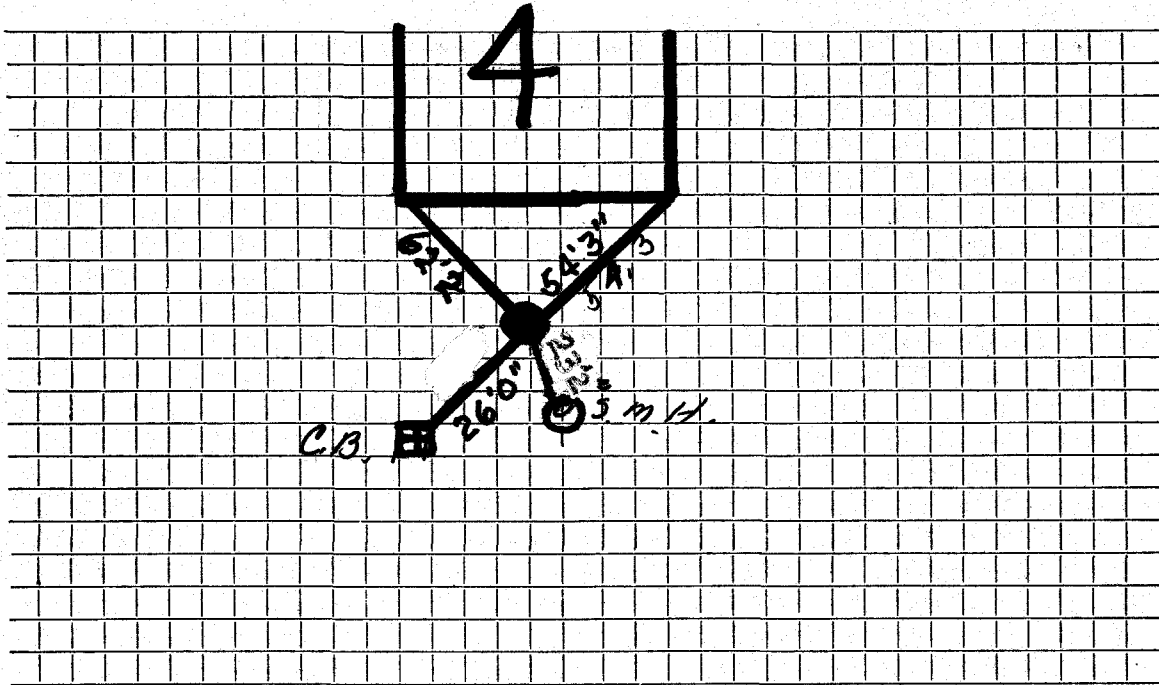

Connection made in Street. Work completed

Remarks:

.....
.....