

WATER SERVICE RECORD

Name Benjamin Franklin Homes, Inc.

Service No. 175

Address 5 White Terrace

Location Lot 15 Sta. 3+73

Request New Service

W.O # 7760


Comm 4-12-63

Date	Material	Amount	Total	Date		Amount
2-27-63	Labor	4.26		12-6-62	Deposit	76.00
	10% O.H.	.43	4.69	4-12-63	X Refund	10.62
56	3/4" Copper tubing @.42		23.52			34.38
1	3/4" C x 1/2 I.W.H.Stop & Waste		6.17		NON CHARGE	
			34.38	10-2-62	Labor	2.31
					99' 3/4" Copper tubing @.42	41.58
					1 3/4" C Corp Cock	4.91
					1 3/4" C Curb Cock	6.28
					1 Box & Rod	4.90
					1 3/4" C 3 Part union	2.41
						62.39
					1 1/2 Straight tailpiece	.50
					1 1/2 Offset tailpiece	.50
						63.39
					<i>X Applied to S11C#217</i>	

DATE _____

TOWN OF LEXINGTON — BOARD OF PUBLIC WORKS

WATER DIVISION

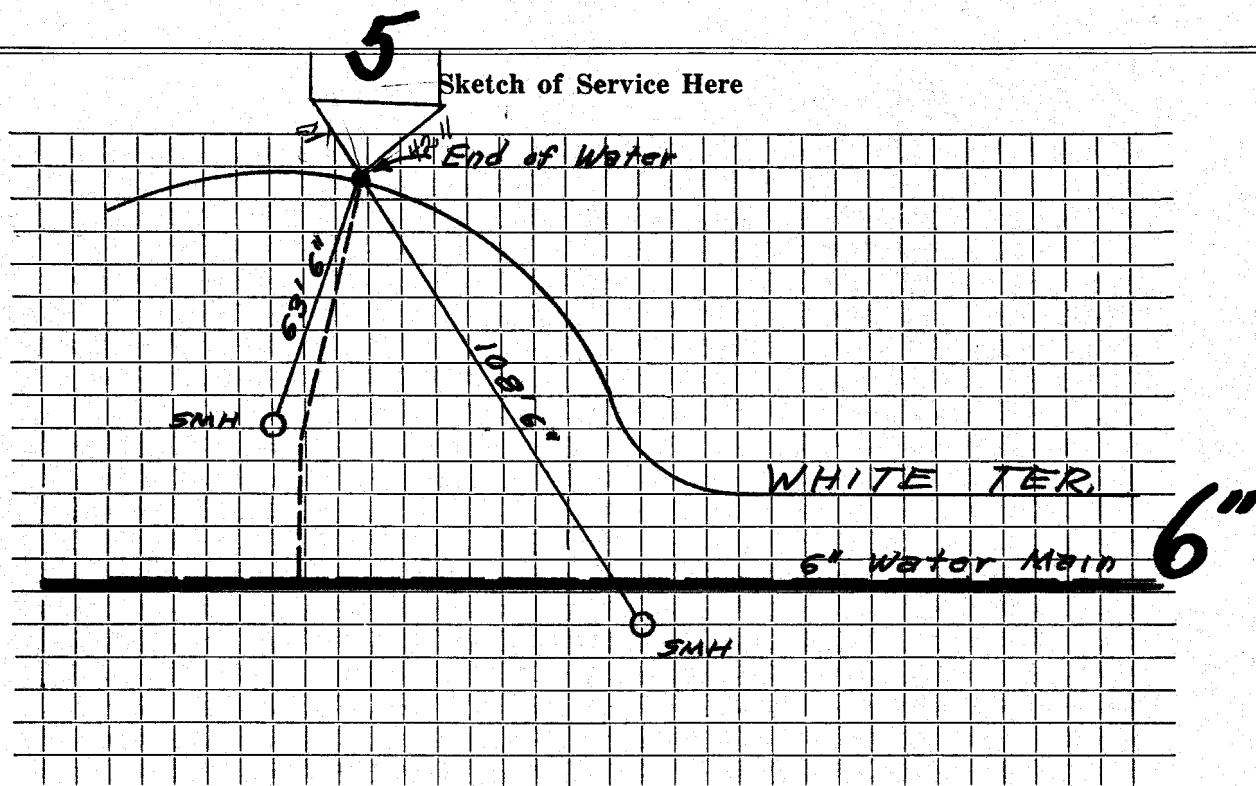

Connection made in Street. Work completed

Remarks: