




DATE \_\_\_\_\_

# TOWN OF LEXINGTON — BOARD OF PUBLIC WORKS

## WATER DIVISION

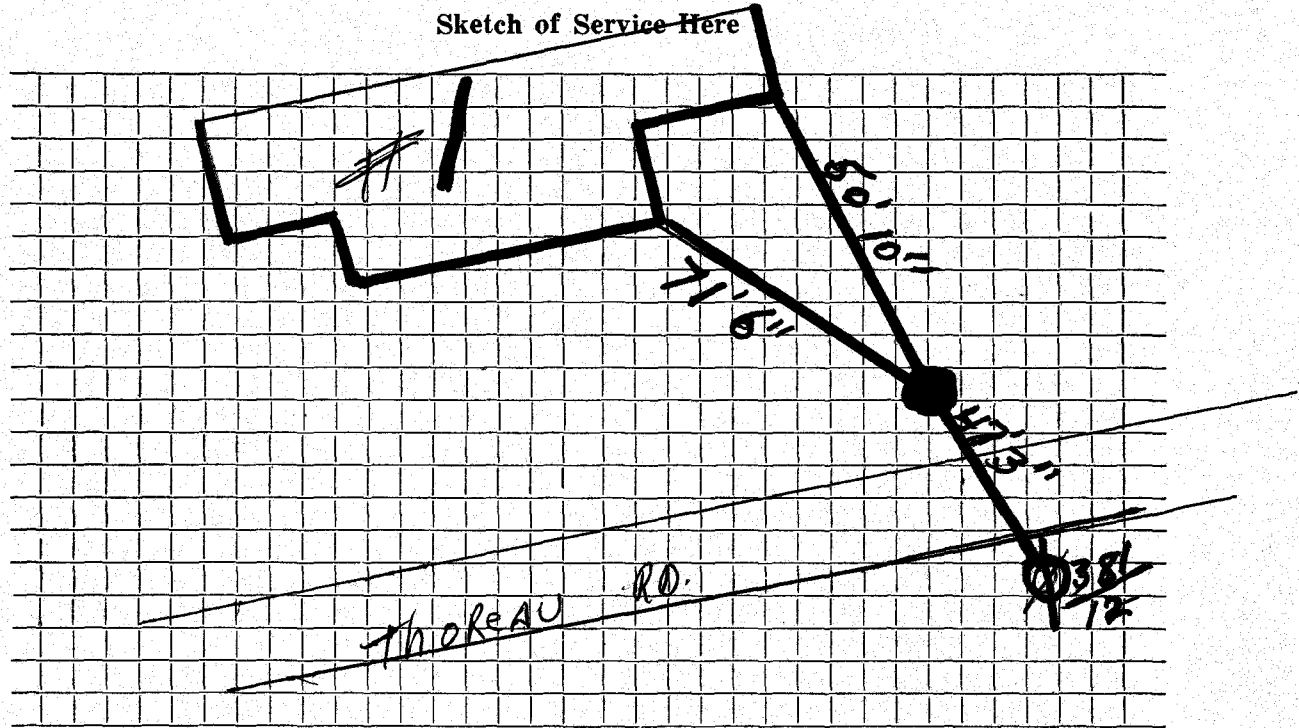

Connection made in ..... Street.      Work completed .....

Remarks: .....

.....

.....