

WATER SERVICE RECORD

Name Ampolo Construction & Engineering Corp.

Service No. 89

Address 2 Whitter Road

Location Lot #10

~~XXXXXX~~ New Service


Comm 8-1-60

Date	Material	Amount	Total	Date	Amount
6-13-60	Labor	20 72		6-8-60	Deposit 75 00
	10% O.H.	2 07	22 79		
	112' 3/4" Copper tubing @42		47 04		
	1 3/4" Cx 1/2 I.W.H. Stop&Waste		6 17		NON CHARGE
	1 3/4" C3 part Union		2 41	9-13-58	Labor 16.95
	2 Hrs. Town shovel @6.50		13 00		25' 3/4" Copper tubing @.37 9.24
	1 Hr. Trucking @3.00		3 00		1 3/4" C Corp Cock 4.64
			94 41		1 3/4" C Curb Cock 6.03
					1 Box & Rod 5.00
					1 hr. Trucking @.75 .75
					<u>42.61</u>
				6-13-60	Labor 18 98
					1 1/2 Straight tailpiece 50
					1 1/2 Offset tailpiece 50
					<u>62 58</u>
					Bill sent 8-1-60 19.41

DATE _____

TOWN OF LEXINGTON — BOARD OF PUBLIC WORKS
WATER DIVISION

Sketch of Service Here

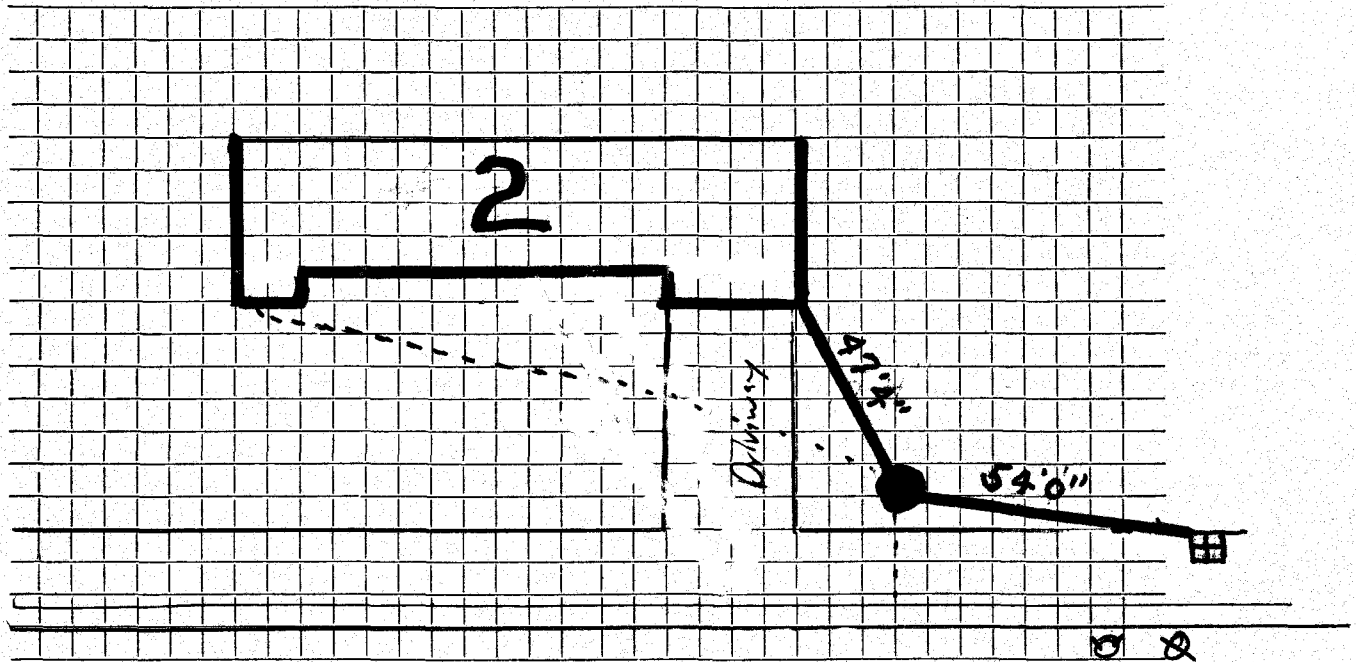

Connection made in Street. Work completed

Remarks:

.....

.....