

WATER SERVICE RECORD

Name

Service No.

Address

Location 10 Wildwood Road

Repair—Renewal—New Service


Date	Material	Amount	Total	Date	Amount
8-4-52					
	60' 3/4" Copper				
	1 3/4" C. X 1/2" I.W.H.			3-22-'52'	
	STOP + Waste				
					30' 3/4" Copper
					1 3/4" C. Corp Cock
					1 3/4" C. X 3/4" C. Curb Cock
					1 Box + Rod
					Repair
					8' 3/4" Copper
					1 3/4" C. Curb Cock
					2 3/4" Style 88 Couplings

DATE _____

TOWN OF LEXINGTON — BOARD OF PUBLIC WORKS

WATER DIVISION

Sketch of Service Here

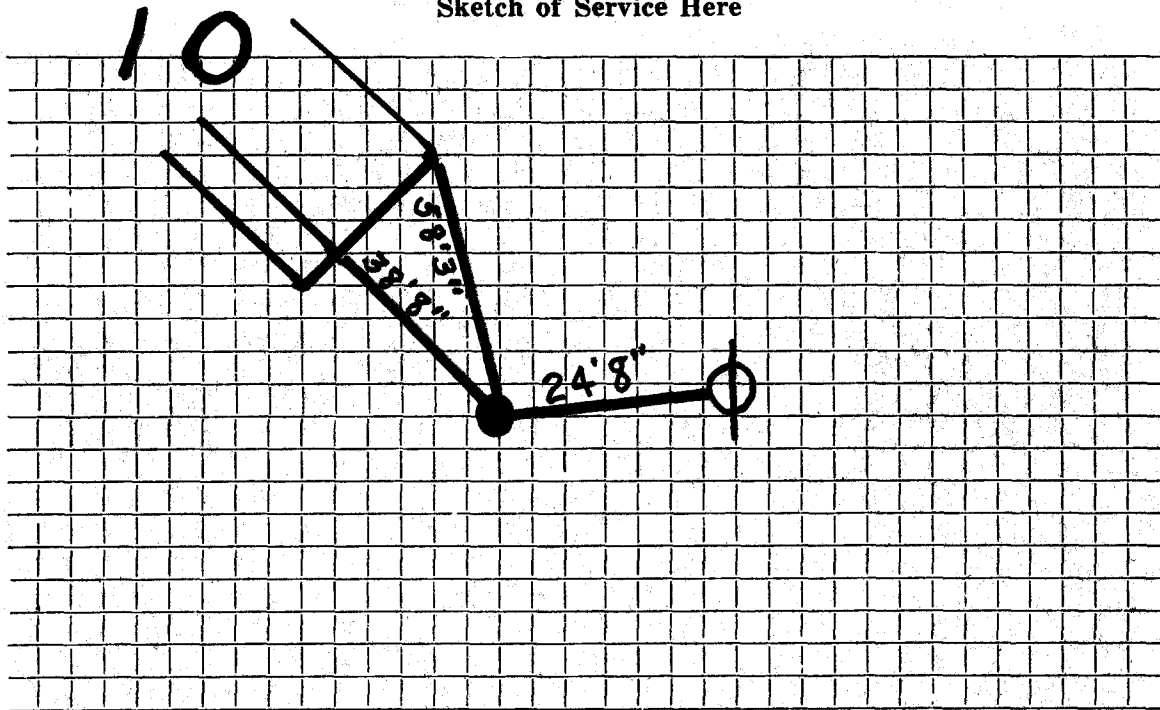

Connection made in Street. Work completed

Remarks:
.....
.....