


DATE 7/15/94

TOWN OF LEXINGTON — BOARD OF PUBLIC WORKS

WATER DIVISION

Sketch of Service Here

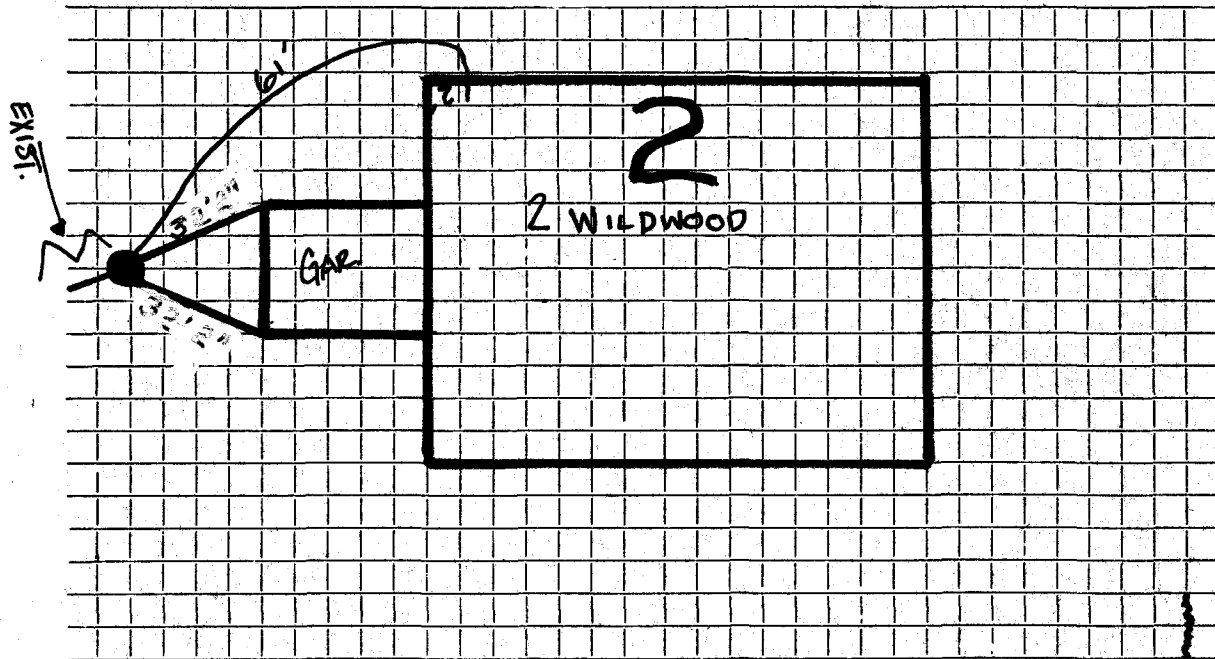

Connection made in WILDWOOD Street. Work completed McLAUGHLIN

Remarks: