

WATER SERVICE RECORD

Name Theodore L. Freeman

Service No. 4

Address 3 Wildwood Road

Location Lexington

~~Repair - Break~~ — New Service Dave Eagle #3367

MAY 21 1979


Date	Material	Amount	Total	Date	Amount	
				3-23-79	Deposit	57 96
					CHARGE CHARGE	
				3/25/52	Labor	25 26
					10' - 3/4" copper tubing @ .3439	3 43
					1 - 3/4" C. corp-cock	4 33
					1 - 3/4" C x 3/4" C. curb-cock	4 67
					1 - box and rod	4 52
					3 hrs. town shovel	15 00
					1 hr. trucking	75
						57 96

DATE _____

TOWN OF LEXINGTON — BOARD OF PUBLIC WORKS

WATER DIVISION

Sketch of Service Here

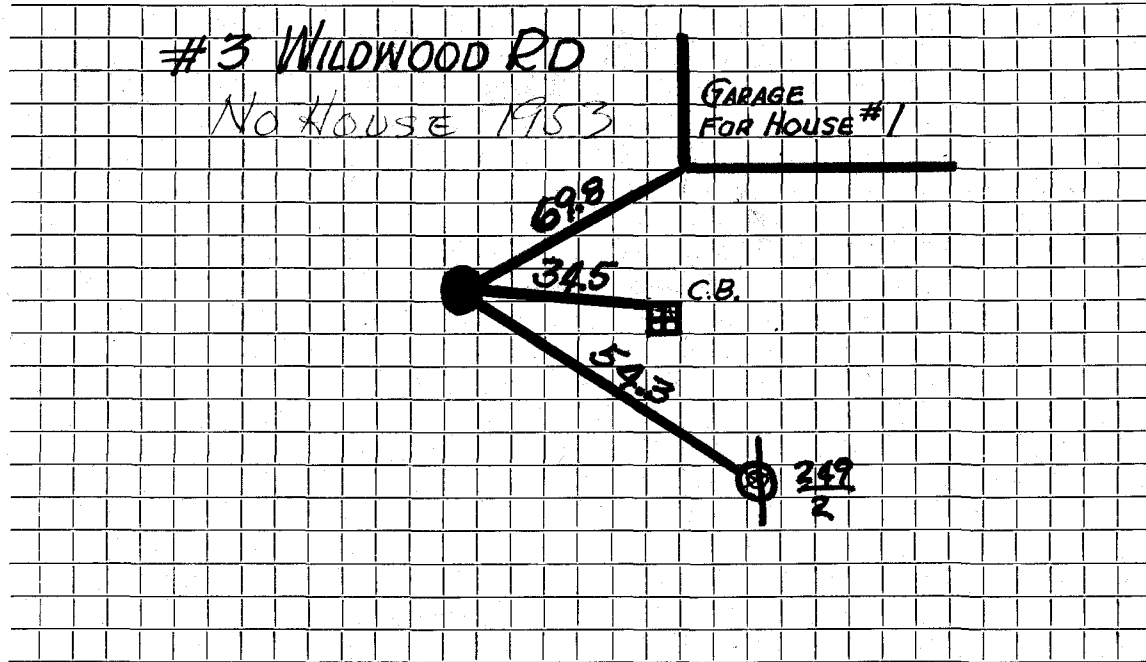

Connection made in Street. Work completed

Remarks:
.....
.....