

WATER SERVICE RECORD

# 4759

Name Neil Morrissey

Service No. 104

Address 4 Wildwood Road

Location

~~Repair~~ ~~Renewal~~ New Service

*Com. 6-13-55*


Date	Material	Amount	Total	Date	Amount
4/25/55	Labor	15 15		4-22-55	Deposited 60 00
	10% overhead	1 52	16 67	6-13-55	Refunded 57
	42' - 3/4" copper tubing@ .3693	15 51			NON CHARGE 59 43
	1 - 3/4" C x 1/2 I.W.H. stop & waste	4 00			SERVICE WAS IN TO CURB:
	3 hrs. Littlefield shovel@7.50	22 50			1 - 1/8 straight tail pc. 50
	1 hr. trucking		75		1 - 1/8 offset tail pc. 50
			59 43	11-23-'51'	1 00
					25' 3/4" Copper
					1 3/4" C. Corp Cock
					1 3/4" C. X 3/4" C. Curb Cock
					1 Box + Rod

TOWN OF LEXINGTON — BOARD OF PUBLIC WORKS

WATER DIVISION

Sketch of Service Here

4

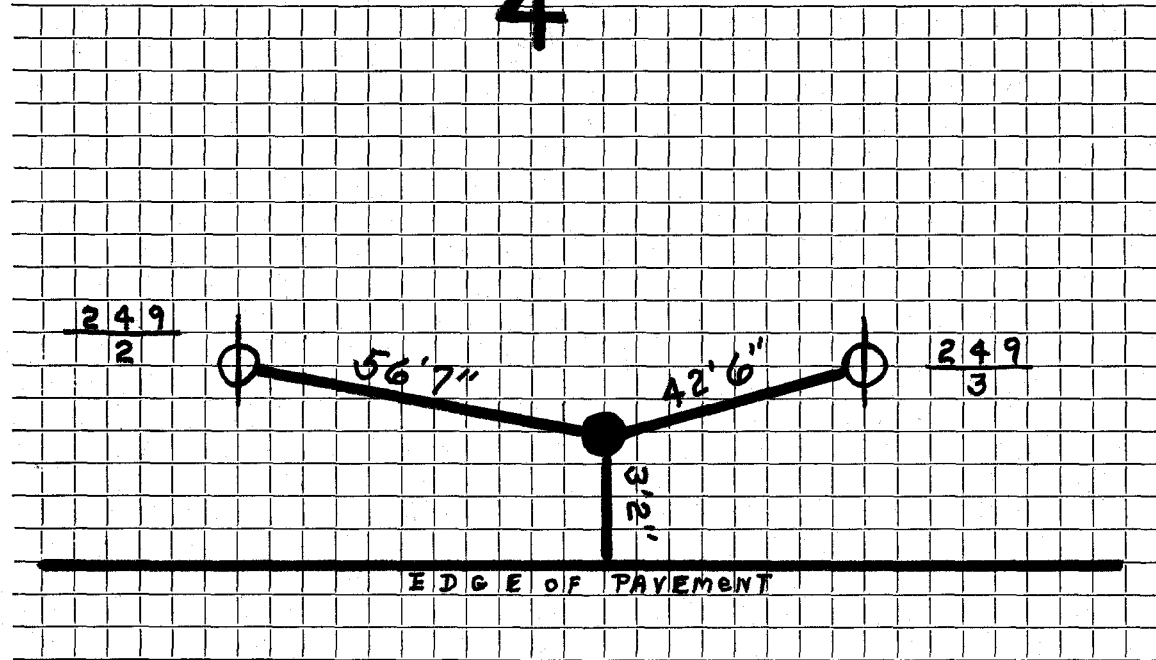

Connection made in ..... Street. Work completed .....

Remarks: .....

.....

.....