

WATER SERVICE RECORD

#4421

Name John Sahagian

Service No. 280

Address 5 Wildwood Road

Location

~~Repair - Renewal~~ - New Service


Com. 12-31-51

Date	Material	Amount	Total	Date	Amount
11-30-51	Labor	1 49	1 49	11-7-51 Deposited	45 00
	10% Overhead		15	12-31-51 Refunded	22 31
	50'-3/4" Copper Tubing @.326		16 30		22 69
	1-3/4" Cx 1/2 I.W.H. S&W		4 00	No Charge	
	1 Hr. Trucking		75	11-30-51 Labor	2 54
	Total		22 69	20'-3/4" Copper Tubing @.326	3 26
				1-3/4" C Corp Cock	1 33
				1-3/4" Cx 3/4" C Curb Cock	4 67
	Trench Dug By Owner			1-Box & Rod	4 68
				1-1/2 Offset Tail Piece	50
				1-1/2 Straight Tail Piece	50
				1 Hr. Trucking	75
				Total	21 23

DATE _____

TOWN OF LEXINGTON — BOARD OF PUBLIC WORKS
WATER DIVISION

Sketch of Service Here

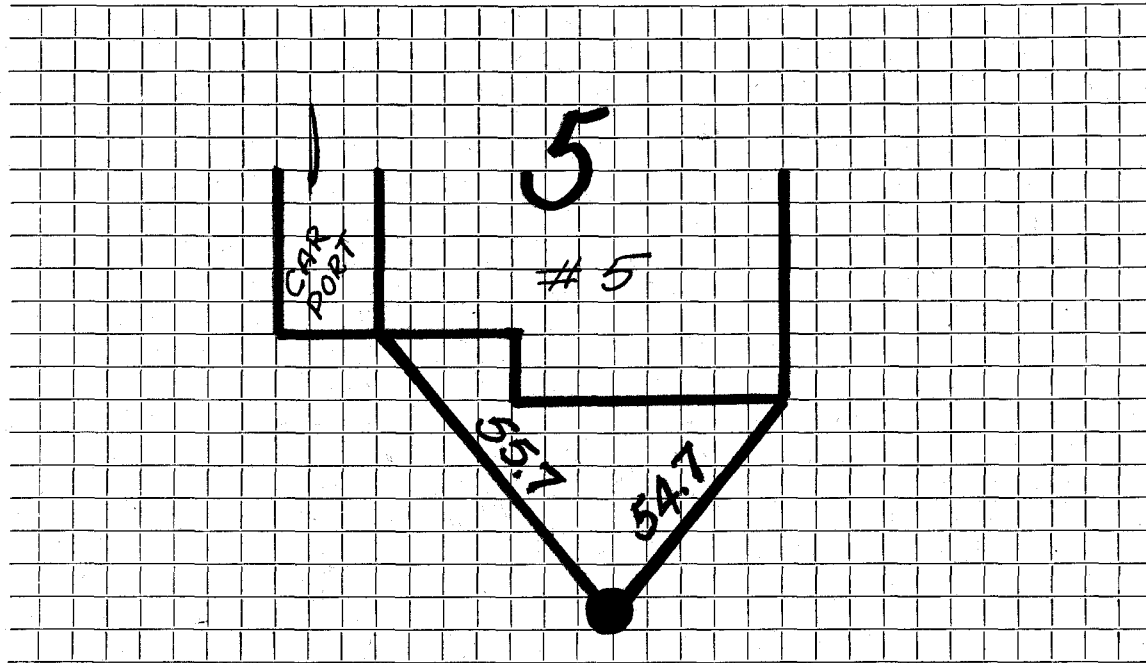

Connection made in Street. Work completed

Remarks :

.....

.....