

WATER SERVICE RECORD

#4155

Name John Mearls

Service No. 326

Address 6 Wildwood Road

Location

~~XXXXXX~~ ~~Repair~~ - New Service

*Com. 12-31-51*


Date	Material	Amount	Total	Date	Amount
11-30-51	Labor	1 49	1 49		
	10% Overhead		15	1-22-52	25 95
	60'-3/4" Copper Tubing @.326		19 56		
	1-3/4"Cx1/2 I.W.H. S&W		4 00		
	1 Hr. Trucking		75		
5-27-'75	Repair	Total	25 95	11-30-51	2 54
	2' 3/4" Copper			25'-3/4" Copper Tubing @.326	8 15
	1 3/4" 3 Part Union			1-3/4"C Corp Cock	4 33
				1-3/4"Cx3/4"C Curb Cock	4 67
				1-Box & Rod	4 68
				1-1/2 Offset Tail Piece	50
				1-1/2 Straight Tail Piece	50
				1 Hr. Trucking	75
				Total	26 12
				<i>bill sent 12-31-51</i>	

DATE \_\_\_\_\_

TOWN OF LEXINGTON — BOARD OF PUBLIC WORKS

**WATER DIVISION**

Sketch of Service Here

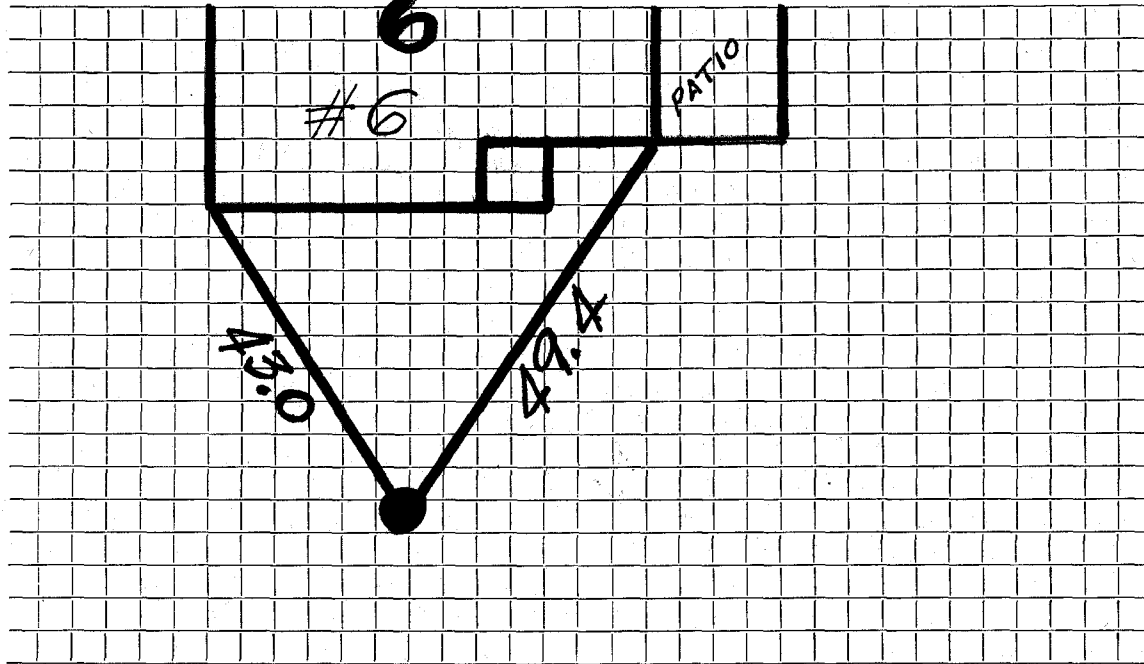

Connection made in ..... Street.                      Work completed .....

Remarks: .....  
.....  
.....