

WATER SERVICE RECORD

Name Lexington Const. Co.

Service No. 186

#4581

Address 7 Wildwood Road

Location Lexington

~~Repair/Remove~~ New Service COM: 9/8/52

Date	Material	Amount	Total	Date	Amount
8/4/52	Labor	1 63			
	10% overhead	16	1 79	10-6-52	34 82
	60' - 3/4" copper tubing @ .326	19 56			
	1 - 3/4" C x 1/2 I.W.H. stop&waste	4 00		8/4/52	Labor 6 26
	1 - 3/4" C x 3/4"C. union 3 pts.	1 72			1 - 1/2 offset tail piece 50
	1 - hr. Littlefield shovel	7 00			1 - 1/2 straight tail piece 50
	1 hr. trucking	75			7 26
			34 82	3/24/52	Labor 22 28
	TRENCH DUG BY OWNER				6' - 3/4" copper tubing@.3439 2 06
					1 - 3/4" C. corp-cock 4 33
					1 - 3/4" C x 3/4" C. curb-cock 4 67
					1 box and rod 4 52
					3 hrs. town shovel 15 00
					1 hr. trucking 75
					53 61
					Total non-charge: \$60 87

*No deposit Paid*  
NON CHARGE


*bill sent 9-9-52*

DATE \_\_\_\_\_

TOWN OF LEXINGTON — BOARD OF PUBLIC WORKS

**WATER DIVISION**

Sketch of Service Here

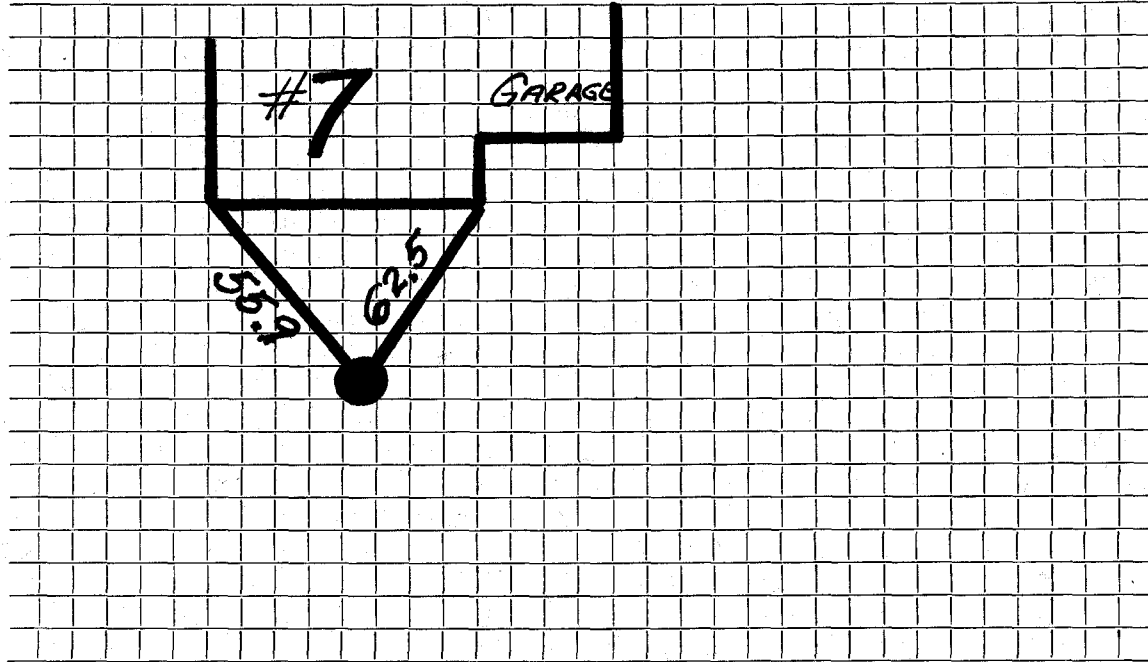

Connection made in ..... Street.      Work completed .....

Remarks: .....

.....

.....