

WATER SERVICE RECORD

Name Anthony Fassnacht

Service No. 255

Address 8 Wildwood Road

#6368

Location

#6369

Repair/Removal—New Service

Com 12-31-51


Date	Material	Amount	Total	Date	Amount
11-23-51	Labor	1 49	1 49	10-20-51 Deposited	45 00
	10% Overhead		15	12-31-51 Refunded	(23 94)
	45'-3/4" Copper Tubing @.326		14 67		21 06
	1-3/4" Cx 1/2" I.W.H. S&W		4 00	No Charge	
	1 Hr. Trucking		75	11-23-51 Labor	4 00
	Total		21 06	25'-3/4" Copper Tubing @.326	8 15
	Trench Dug By Owner			1-3/4" C Corp Cock	4 33
				1-3/4" Cx 3/4" C Curb Cock	4 67
				1-Box & Rod	4 68
				1-1/2" Offset Tail Piece	50
				1-3/4" Cx 3/4" C Union (3 pts)	1 72
				1-1/2" Straight Tail Piece	50
				1 Hr. Trucking	75
				Total	29 30

DATE _____

TOWN OF LEXINGTON — BOARD OF PUBLIC WORKS

WATER DIVISION

Sketch of Service Here

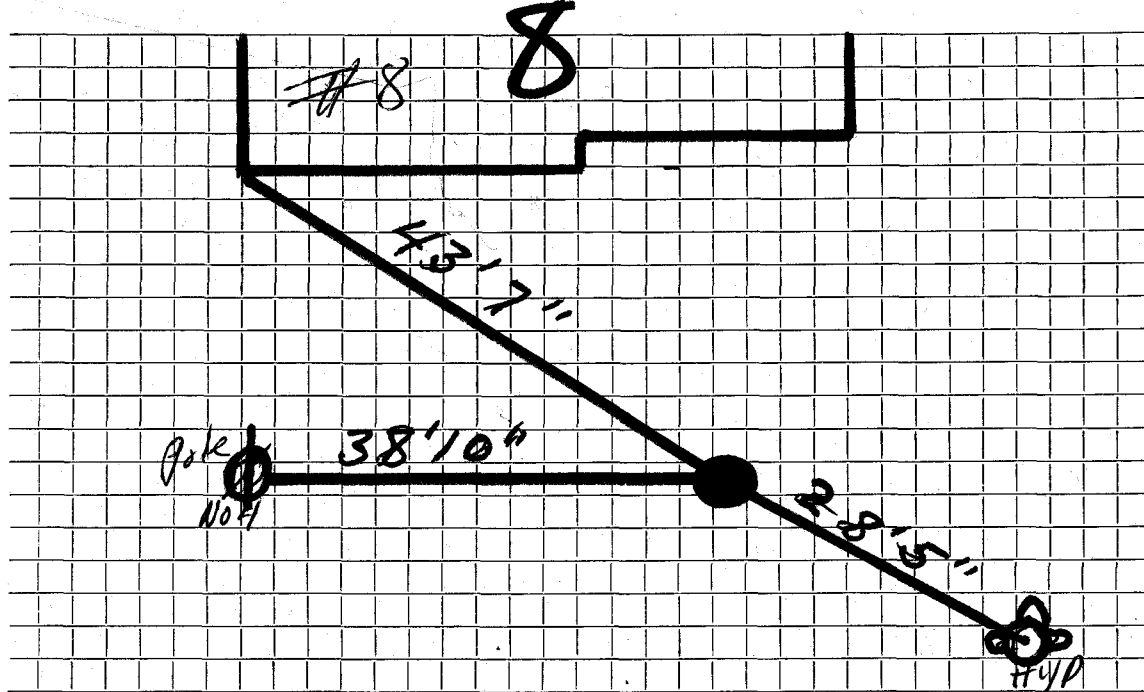

Connection made in Street. Work completed

Remarks:

.....

.....