

WATER SERVICE RECORD

Name **William H McNamara**

Service No. **282**

Address **9 Wildwood Road (changed from 12 Patterson Rd.)**

Location

~~Repair - Renewal~~ - New Service


com. 12-31-51

Date	Material	Amount	Total	Date	Amount
11-23-51	Labor	1 49	1 49	11-9-51 Deposited	45 00
	10% Overhead		15	12-31-51 Rejected	19 05
	60'-3/4" Copper Tubing @.326		19 56		25 95
	1-3/4" Cx 1/2 I.W.H. S&W		4 00	No Charge	
	1 Hr. Trucking		75	11-23-51 Labor	4 25
	Total		25 95	27'-3/4" Copper Tubing @.326	8 80
				1-3/4" C Corp Cock	4 33
				1-3/4" Cx 3/4" C Curb Cock	4 67
				1 Box & Rod	4 68
	Trench Dug By Owner			1-1/2 Straight Tail Piece	50
				1-1/2 Offset Tail Piece	50
				1 Hr. Trucking	75
				Total	28 48

DATE _____

TOWN OF LEXINGTON — BOARD OF PUBLIC WORKS
WATER DIVISION

Sketch of Service Here

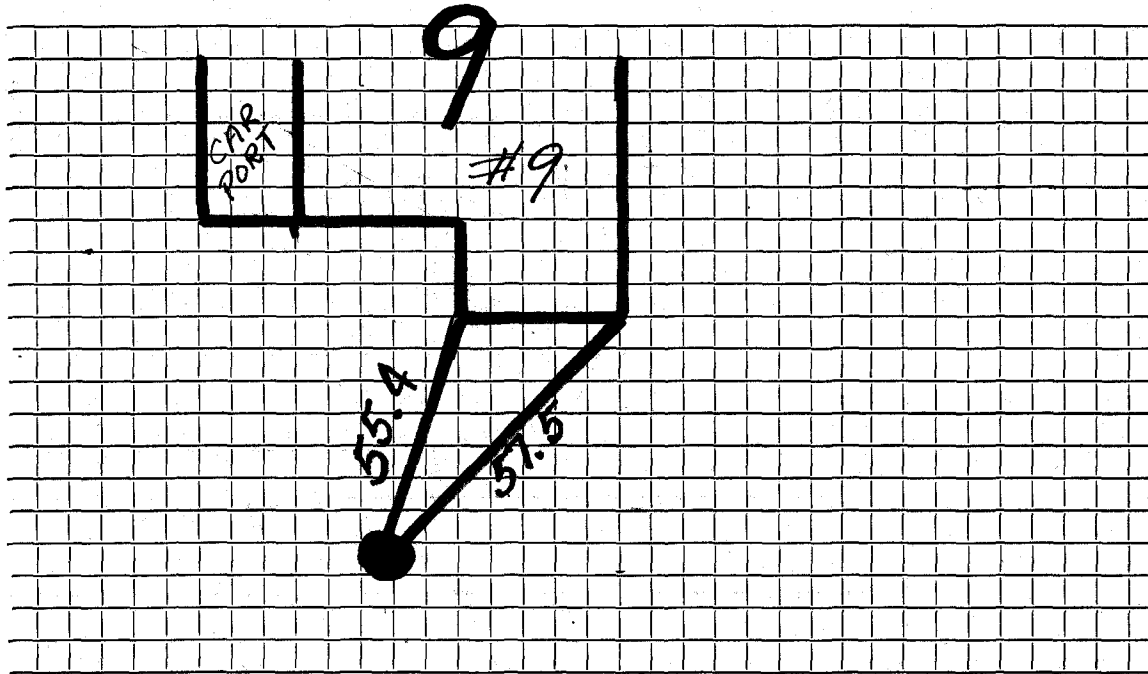

Connection made in Street. Work completed

Remarks:
.....
.....