

WATER SERVICE RECORD

Name

Service No.

Address

10 Williams Road
~~347 Bedford Street~~

Location

Lexington, Mass.

~~Repair~~ - Renewal - ~~New Service~~


Date	Material	Amount	Total	Date	Amount
					No Charge
				10-20-50	Labor 21 00
				1/1'	3/4" Copper Tubing @.31 12 71
				1	3/4" C Corp-cock 3 60
				1	1" C x 1" I Curb-cock 5 60
				1	1" Close Nipple 50
				1	3/4" C x 1" I Union (2 pts.) 1 13
				1	Box & Rod 4 44
					Littlefield Shovel 3 hrs. @ 7.00 21 00
					Trucking 1 hr. @.75 75
					<u>70 73</u>
					NO CHARGE
				2'	3/4" Copper tubing @ .24 48
				1	3/4" C Corp cock 3 15
				1	3/4" Repair Clamp 1 34
					<u>4 97</u>

DATE _____

TOWN OF LEXINGTON — BOARD OF PUBLIC WORKS

WATER DIVISION

Sketch of Service Here

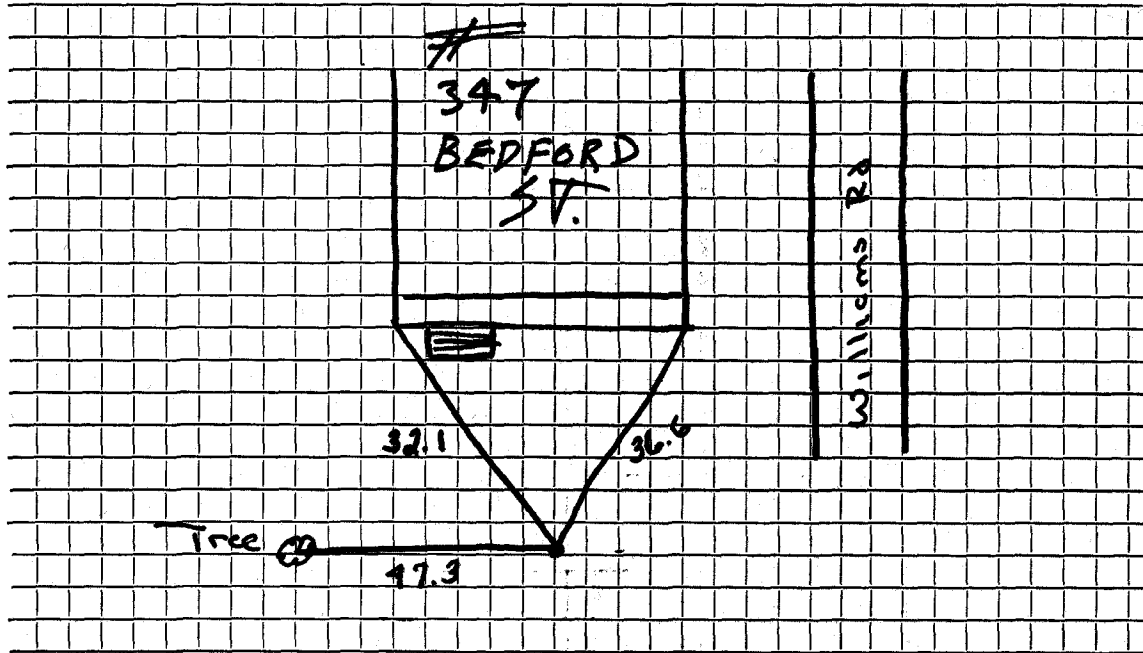

Connection made in Street. Work completed

Remarks:
.....
.....