

WATER SERVICE RECORD

Name William H. Sullivan

Service No. 193

Address 15 Williams Road

Location Lexington

~~Repair/Reinstall~~ - New Service

C.M. 9-22-52


Date	Material	Amount	Total	Date	Amount
9/5/52	Labor	1 63		8-28-52	Deposited 20 00
	10% overhead	16	1 79	9-24-52	Paid 1 67
	44' - 3/4" copper tubing@ .3439		15 13		<u>NON CHARGE</u> 21 67
	1 - 3/4" C x 1/2 I.W.H. stop & waste		4 00	9/5/52	Labor 1 63
	1 hr. trucking		75		16' - 3/4" copper tubing@.3439 5 50
			21 67		1 - 3/4" C. corp-cock 4 33
					1 - 3/4" C x 3/4" C. curb-cock 4 67
					1 - box and rod 3 90
					1 - 1/2 offset tail piece 50
					1 - 1/2 straight tail piece 50
					1 hr. trucking 75
					<u>21 78</u>

DATE _____

TOWN OF LEXINGTON — BOARD OF PUBLIC WORKS

WATER DIVISION

Sketch of Service Here

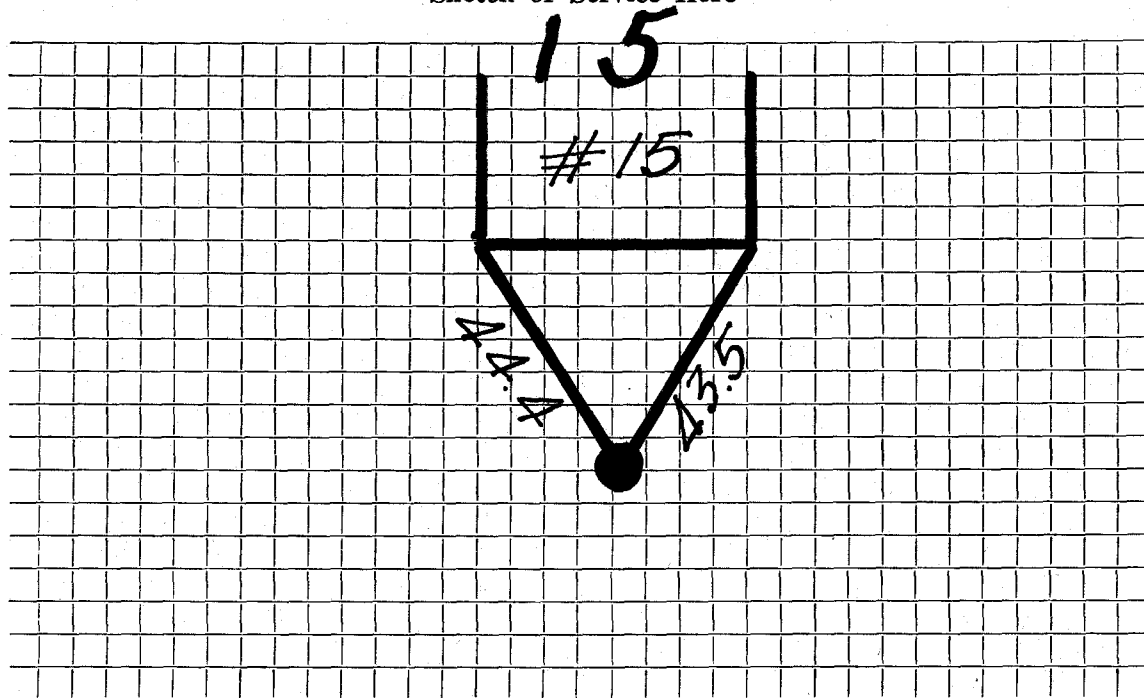

Connection made in Street. Work completed

Remarks:

.....

.....