

Name Richard Dennis

Service No. 282

Address 16 Williams Road

2788

Lexington, Mass.

Locatic 16 Williams Road

Kind of Pipe

Size

Size of Main

~~Renewal~~ - New Service

Com. 11-6-50

Location

Date	Material	Amount	Total	Date	Amount
Sept. 15, '50	Labor	1 50	1 50	Aug 30 '50	15 00
	10% Overhead		15	Sept. 15 '50	5 82
	48' - 3/4" Copper Tubing @.275	13 20	13 20	Nov. 24 '50	1 76
	1 - 3/4" C x 1/2" I.W.H. S&W	3 76	3 76		22 58
	2 - 3/4" C x 3/4" C Unions (3pts)	3 22	3 22	Sept. 15, '50	3 60
	Trucking 1 hr. @.75	75	75	10' - 3/4" Copper Tubing @.275	2 75
			22 58	1 - 3/4" C Corp-cock	3 60
				1 - 3/4" C x 3/4" C Curb-cock	4 40
				1 - Box & Rod	3 35
				1 - 1/2" Offset Tail Piece	42
				1 - 1/2" Straight Tail Piece	42
				Trucking 1 hr. @.75	75
				1-21-81	19 29
				Repair	
				2 1/2' 3/4" Copper	
				1 3/4" C. Comp Cock	
				1 3/4" Style 88	
				1 6" X 20" 360 All Around Clamp	

Bill sent 11-2-50

Deposited
Cash
Card
No Charge15 00
5 82
1 76
22 58

Hidley Press, Inc., Lexington

DATE _____

TOWN OF LEXINGTON—BOARD OF PUBLIC WORKS

WATER DIVISION

The undersigned applies for a supply of water at No. _____ St. and hereby agrees to comply with the rules and regulations as now, or at any future time, established by the Board of Selectmen.


Am't. of Estimate \$ _____

Owner _____

Am't. Paid \$ _____

Address _____

Builder _____

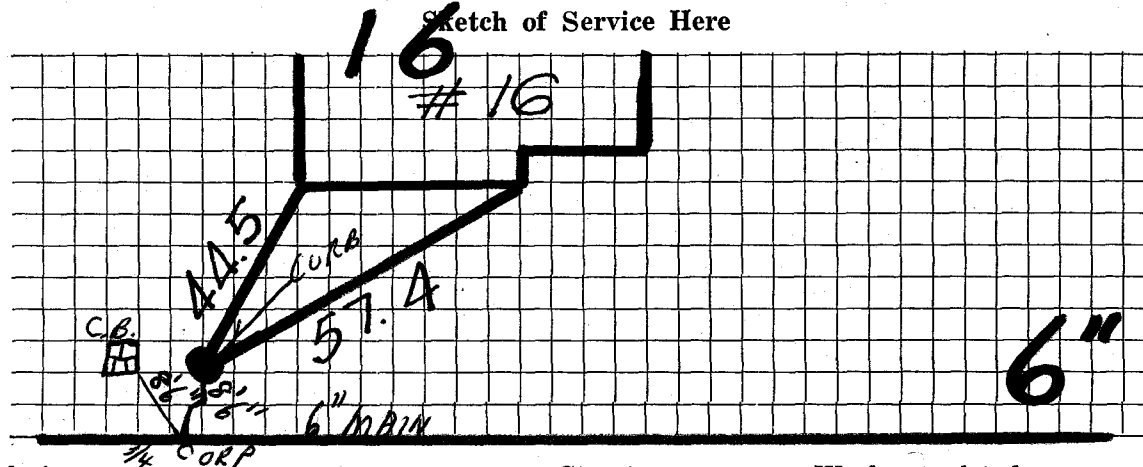

Connection made in _____ Street.

Work completed _____ 19

Remarks: