


TOWN OF LEXINGTON — BOARD OF PUBLIC WORKS

WATER DIVISION

Sketch of Service Here

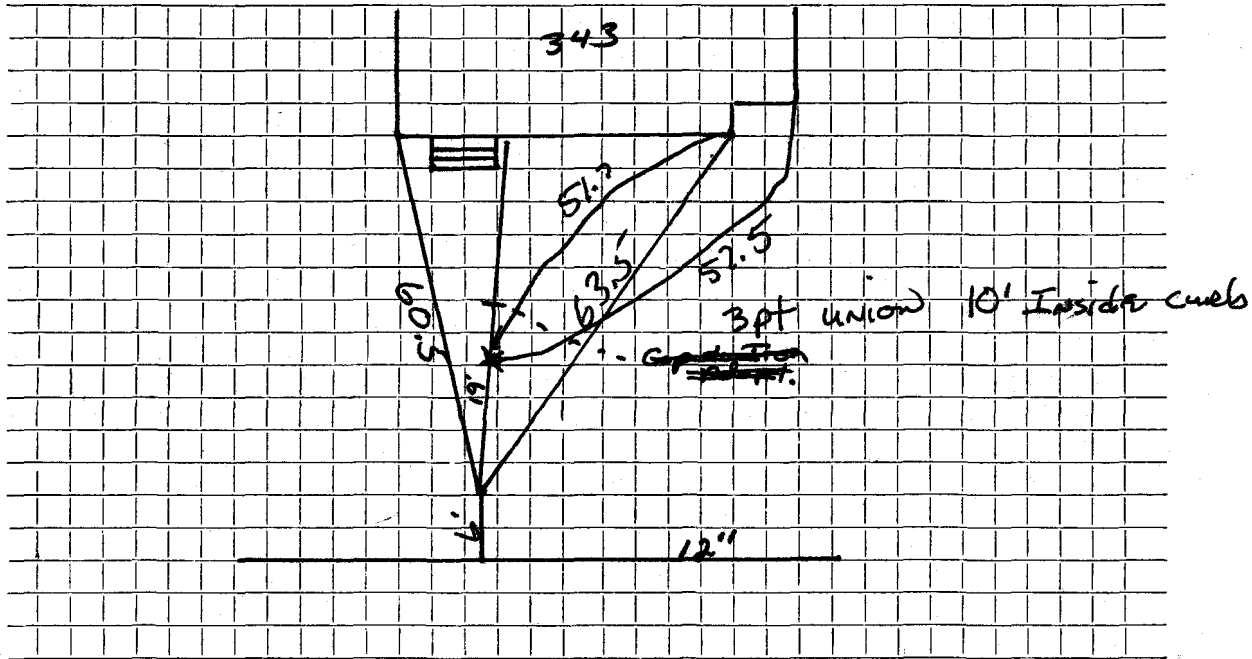

Connection made in Street. Work completed ... 5-26-99

Remarks: .. 12" Drain 20'4" From Curb STap 4" Gas .. 13'4" From Curb

.. Adapt Cop - Iron .. 1' Outside OF Drain .. 19' From Curb